Posted → 9/17/01 mf

IREDELL COUNTY HEALTH DEPARTMENT

STATESVILLE 704-878-5305 MOORESVILLE 704-664-5281

IMPROVEMENT PERMIT / AUTHORIZATION TO CONSTRUCT / OPERATION PERMIT / EXISTING SYSTEM INSPECTION

PERMIT# 88796 PIN# 4726316491 PT DATE 7/5/00

OWNER OR CONTRACTOR RICHARD WILSON PHONE: Business 873 9034 Home

ADDRESS 2210 JAMES WAY STATESVILLE

LOCATION SCOTTS CREEK - TL MILLER FARM - TR OFF TR DEERCROFT - ON LT

SUBDIVISION DEERCROFT BLOCK / SECTION 4 LOT 190 LOT AREA 1.5 AC SITE CLASS PS DESIGN FLOW 360 GPD L.T.A.R. 1.39 AC/FT

Septic Tank: 1000 Gallons; STB 1012 Date 6-17-01
Pump Tank: Gallons; PT Date
Pump Make: Model Serial No.
Nitrification Field: No Fields 1 Square Feet 1200 Linear Feet 400
No Lines 5 @ 80' Trench Width 36" Max Trench Bottom Depth 36" Gravel Depth 12"

☑ New System ☐ Repair System Type: I (II) III. IV. V. VI
System Description: GRAVITY CONVENTIONAL
Repair System Description: SAME
Maintenance Agreement Required: ☐ Yes ☑ No

☑ House/Mod. Home No. Bedrooms 3
☐ Mobile Home No. Bathrooms 2
☐ Business No. Employees
☐ Other


☐ Slab ☑ Crawl Space ☐ Basement w/plumbing ☐ Basement wo/plumbing

Water Supply: ☐ Individual ☑ Public ☐ Community


Comments:/Conditions:

Comments:/Conditions.
- Poly Lok Filter Installed
- Septic Tank Marker Installed

INITIAL SITE SKETCH 1" = 50'

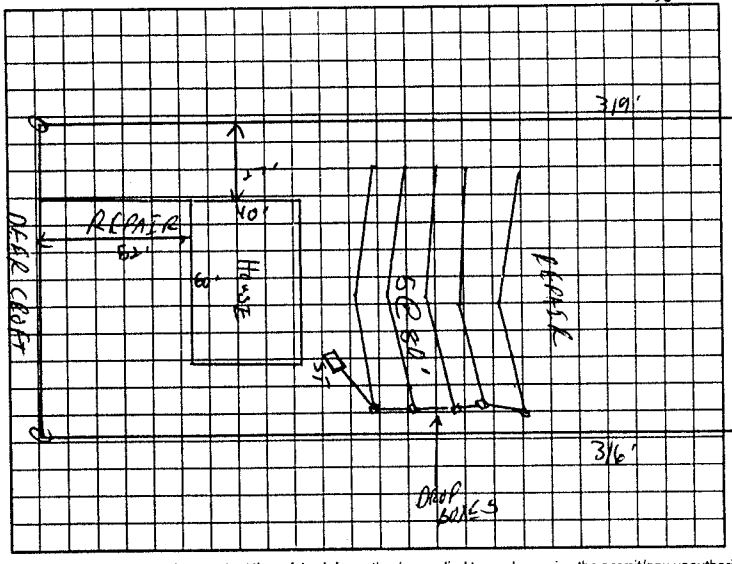

AS BUILT SKETCH

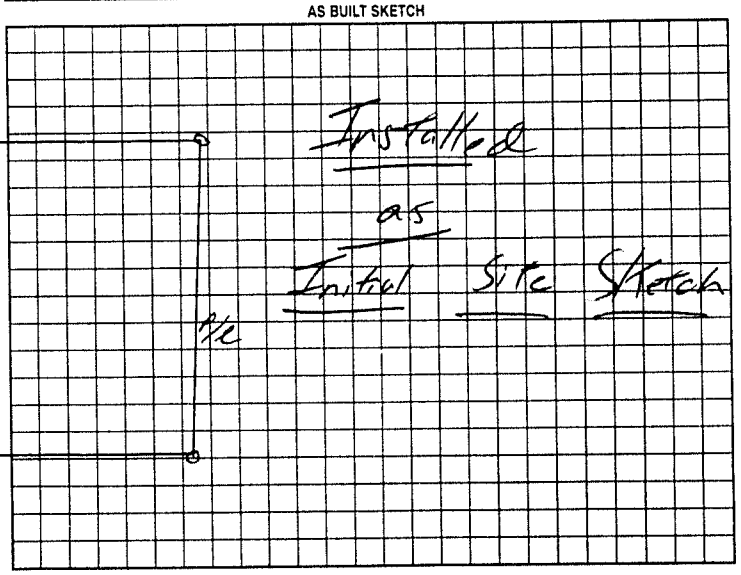

Permit can be suspended or revoked if any false information is supplied toward securing the permit/any unauthorized changes are made to the site/any unauthorized changes are made in the installation of the system. Improvement Permit with plat valid without expiration. Improvement Permit with site plan valid for sixty months. Authorization to Construct is valid for a period equal to that of Improvement Permit – not to exceed sixty months.

Signed: Richard Wilson date 7/13/00

Improvement Permit by: [signature] date 7/5/00

Authorization to Construct by: [signature] date 7/5/00

Installed by: Steve Jordan

Operation Permit by: William O Johnson date 9/14/01

Existing System Inspection by: date

HEALTH DEPT. COPY: WHITE OWNER COPY (FINAL): YELLOW OWNER COPY (INITIAL): PINK