54095

IREDELL COUNTY HEALTH DEPARTMENT

STATESVILLE 704-878-5305 MOORESVILLE 704-664-5281

IMPROVEMENT PERMIT / CERTIFICATE OF COMPLETION / OPERATION PERMIT / EXISTING SYSTEM INSPECTION

PROPERTY DESCRIPTION NO. 19980 DATE 1/4/95 TAX MAP NO. 9A-9-A-79 Watershed: ☐ Yes ☒ No

OWNER OR CONTRACTOR A. J. BUILDING CO. PHONE: Business Home 871-0940

ADDRESS 146 HUNTER RIDGE LANE, STE NC 28677

LOCATION NC 115 N, TL SCOTTS CREEK ROAD, TL MILLER FARM ROAD, TR DOE TRAIL, LOT ON (R)

SUBDIVISION DEERCROFT BLOCK / SECTION II LOT 79 LOT AREA 110'x200' SITE CLASS PS DESIGN FLOW 360 L.T.A.R. 0.33 GPD/FT

Septic Tank: 1000 Gallons; STB 794 Date 1/27/95

Pump Tank: _____ Gallons; PT _____ Date _____

Pump Make: _____ Model _____ Serial No. _____

Nitrification Field: No Fields 1 Square Feet 1080 Linear Feet 360

No Lines 4 Trench Width 36" Max Trench Bottom Depth 18-36" Gravel Depth 12"

☒ New System ☐ Repair System Type: I, II, III, IV, V, VI

System Description: CONV. GRAVITY

Repair System Description: CONV. GRAVITY / PUMP

Maintenance Agreement Required: ☐ Yes ☒ No

☒ House/Mod. Home No. Bedrooms 3

☐ Mobile Home No. Bathrooms 2

☐ Business No. Employees _____

☐ Other _____


☐ Slab ☒ Crawl Space ☐ Basement w/plumbing ☐ Basement wo/plumbing

Water Supply: ☐ Individual ☐ Community ☒ Public

Comments: (1) KEEP SYSTEM MINIMUM 5' FROM HOUSE, 10' FROM PROPERTY LINE 10' FROM WATER LINE (2) INSTALL LINES AS SHALLOW AS POSSIBLE ON CONTOUR, 9' APART MINIMUM ON CENTER

Comments:

INITIAL SITE SKETCH

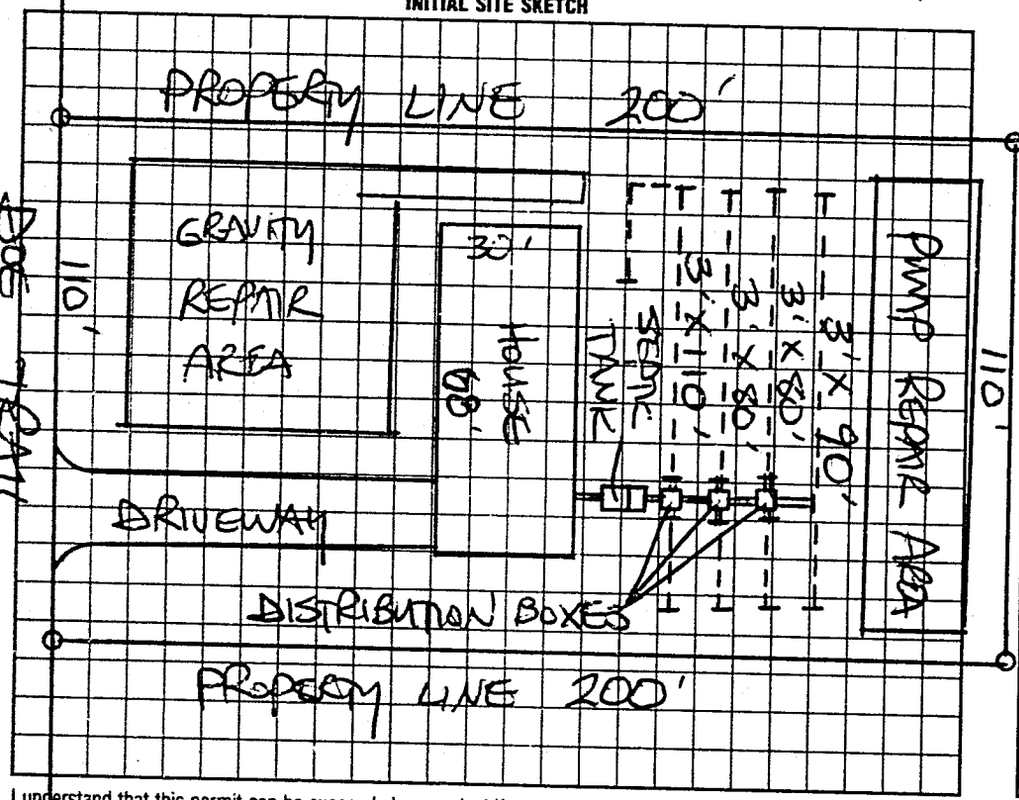

AS BUILT SKETCH

SYSTEM INSTALLED ACCORDING TO INITIAL SITE SKETCH

I understand that this permit can be suspended or revoked if any false information is supplied toward securing the permit/any unauthorized changes are made to the site/any unauthorized changes are made in the installation of the system. Improvement Permit is valid for 60 months from date of issuance.

Signed: Jeffrey E. Whitley

Improvement Permit by: STEVE HEDRICK date 1/4/95

Existing System Inspection by: _____ date _____

Installed by: A-1 BACKHOE

Certificate of Completion by: STEVE HEDRICK date 3/21/95

Operation Permit by: _____ date _____

HEALTH DEPT. COPY: WHITE INSPECTION COPY (FINAL): GREEN OWNER COPY (FINAL): YELLOW INSPECTION COPY (INITIAL): PINK OWNER COPY (INITIAL): GOLD

5/18/00