THIS PERMIT VOIDS PREVIOUS ISSUED 11-9-2000

IREDELL COUNTY HEALTH DEPARTMENT

STATESVILLE 704-878-5305 MOORESVILLE 704-664-5281

IMPROVEMENT PERMIT / AUTHORIZATION TO CONSTRUCT / OPERATION PERMIT / EXISTING SYSTEM INSPECTION

PERMIT# 092870 PIN# 4726 31 6491 (PART) DATE 4-12-2001

OWNER OR CONTRACTOR WOOD BROTHERS CONST. PHONE: Business (704) 539-4520 Home (828) 396-1126

ADDRESS 160 INDIAN HILL ROAD, UNION GROVE NC 28689

LOCATION NC 115 N, TR SCOTTS CREEK RD, TL MILLER FARM RD, TR DOE TRAIL, TR DEERCROFT DR, AT END ON RIGHT

SUBDIVISION DEERCROFT BLOCK / SECTION IV LOT 194 LOT AREA 0.548 ACRE SITE CLASS PS DESIGN FLOW 360 L.T.A.R. 0.30 GPD/FT²

Septic Tank: 1000 Gallons; STB 1012 Date 2-20-01
Pump Tank: 1000 Gallons; PT 17 Date 8-29-00
Pump Make: HYDROMATIC Model SK50A1 Serial No
Nitrification Field: No Fields 1 Square Feet EQ. TO 1200 Linear Feet 300'
No Lines FIVE Trench Width 36" Max Trench Bottom Depth 36" Gravel Depth N/A

☐ New System ☐ Repair System Type: I, II, (III), IV, V, VI
System Description: 25% REDUCTION, PUMP
Repair System Description: 50% REDUCTION, LOW-PRESS,
Maintenance Agreement Required: ☐ Yes ☒ No
☐ Slab ☒ Crawl Space ☐ Basement w/plumbing ☐ Basement wo/plumbing


☒ House/Mod. Home No. Bedrooms 3
☐ Mobile Home No. Bathrooms 2
☐ Business No. Employees
☐ Other

Water Supply: ☐ Individual ☒ Public ☐ Community


Comments/Conditions: ① INSTALL 25% REDUCTION SYSTEM USING FIFTY (50) CHAMBERS OR THIRTY (30) HDS SECTIONS ② SEE ATTACHED SHEETS FOR PUMP AND PRESSURE MANIFOLD REQUIREMENTS

Comments/Conditions: ① SEPTIC TANK WITH MARKER INSTALLED USING "POLYLOK" FILTER ② SYSTEM PRESSURE CHECKED 5-1-01 BY RSH - O.K.

INITIAL SITE SKETCH

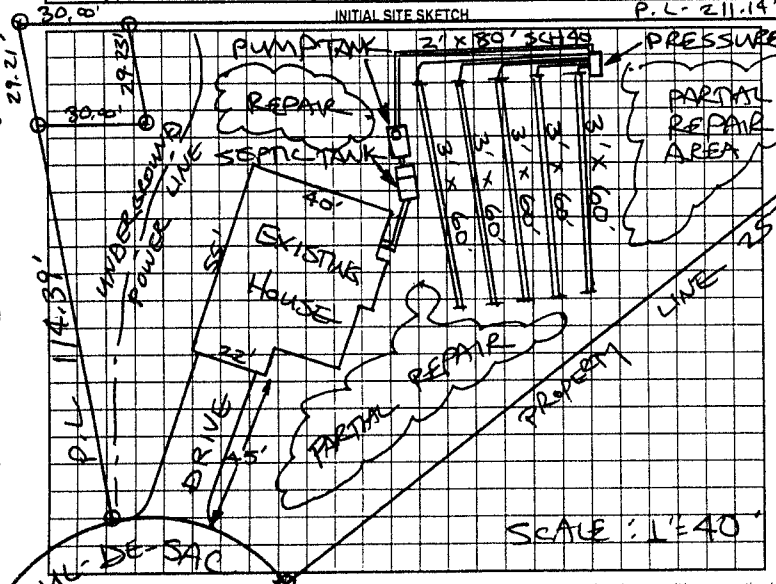

AS BUILT SKETCH

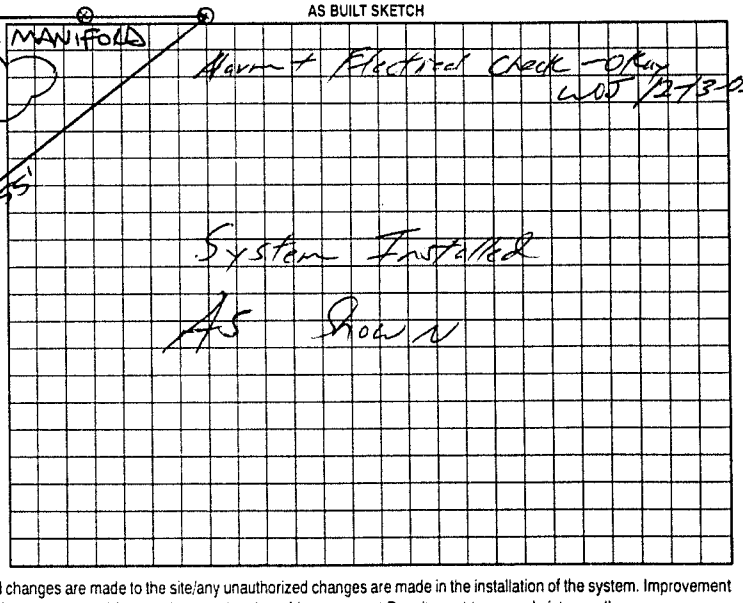

Permit can be suspended or revoked if any false information is supplied toward securing the permit/any unauthorized changes are made to the site/any unauthorized changes are made in the installation of the system. Improvement Permit with plat valid without expiration. Improvement Permit with site plan valid for sixty months. Authorization to Construct is valid for a period equal to that of Improvement Permit – not to exceed sixty months.

Signed: Dennis Dallik date

Installed by: A-1 BACKHOE

Improvement Permit by: STEVE HEDRICK date 4-12-01

Operation Permit by: William O Johnson date 12/13/02

Authorization to Construct by: STEVE HEDRICK date 4-12-01

Existing System Inspection by: date

HEALTH DEPT. COPY: WHITE OWNER COPY (FINAL): YELLOW OWNER COPY (INITIAL): PINK