IREDELL COUNTY HEALTH DEPARTMENT

STATESVILLE 704-878-5305 MOORESVILLE 704-664-5281

IMPROVEMENT PERMIT / AUTHORIZATION TO CONSTRUCT / OPERATION PERMIT / EXISTING SYSTEM INSPECTION

PERMIT# 083484 PIN# 4726 31 6491 (PT) DATE 8-24-99

OWNER OR CONTRACTOR DIAMOND PARTNERS PHONE: Business 872-3785 Home

ADDRESS 220 JAMIE DRIVE, STATESVILLE NC 28677

LOCATION NC115 N, TL SCOTS CREEK, TL MILLER FARM, TR BOG TRAIL, TR DEERCROFT DR, 2ND LOT ON (R)

SUBDIVISION DEERCROFT BLOCK / SECTION IV LOT 201 LOT AREA 0.607 ACRE SITE CLASS PS DESIGN FLOW 360 L.T.A.R. 0.33 GPD/FT²

Septic Tank: 1000 Gallons; STB 3-11-00 Date 10/2

Pump Tank: Gallons; PT Date

Pump Make: Model Serial No

Nitrification Field: No Fields 1 Square Feet 1080 Linear Feet 360

No Lines THREE Trench Width 36" Max Trench Bottom Depth 36" Gravel Depth 12"

☑ New System ☐ Repair System Type: I (II) III, IV, V, VI

System Description: CONVENTIONAL GRAVITY

Repair System Description: CONV. GRAVITY

Maintenance Agreement Required ☐ Yes ☑ No

☑ House/Mod. Home ☐ Mobile Home ☐ Business ☐ Other

No. Bedrooms 3 No. Bathrooms 2 No. Employees


☐ Slab ☑ Crawl Space ☐ Basement w/plumbing ☐ Basement wo/plumbing

Water Supply: ☐ Individual ☑ Public ☐ Community


Comments/Conditions:

Comments/Conditions

INITIAL SITE SKETCH

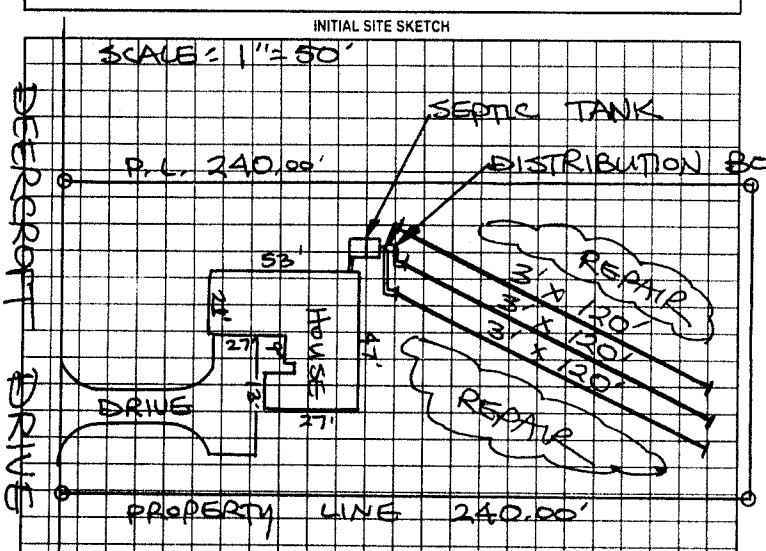

AS BUILT SKETCH

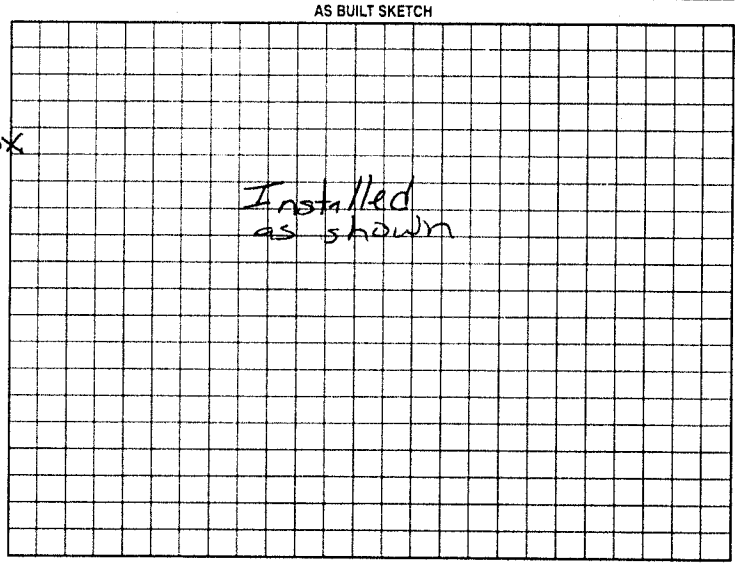

Permit can be suspended or revoked if any false information is supplied toward securing the permit/any unauthorized changes are made to the site/any unauthorized changes are made in the installation of the system. Improvement Permit with plat valid without expiration. Improvement Permit with site plan valid for sixty months. Authorization to Construct is valid for a period equal to that of Improvement Permit – not to exceed sixty months.

Signed: Donna M. Roberts date 8-24-99 Installed by: Steve Jordan

Improvement Permit by: STEVE HEDRICK date 8-24-99 Operation Permit by: [signature] date 5-26-00

Authorization to Construct by: STEVE HEDRICK date 8-24-99 Existing System Inspection by: date

HEALTH DEPT COPY WHITE OWNER COPY (FINAL) YELLOW OWNER COPY (INITIAL) PINK