IREDELL COUNTY HEALTH DEPARTMENT

STATESVILLE 704-878-5305 #125 MOORESVILLE 704-664-5281

IMPROVEMENT PERMIT / AUTHORIZATION TO CONSTRUCT / OPERATION PERMIT / EXISTING SYSTEM INSPECTION

PERMIT# 90059 PIN# 4726316491 PT DATE 7/5/00

OWNER OR CONTRACTOR R & L CONTRACTORS PHONE: Business 880-8219 Home

ADDRESS 289 SHARON SCHOOL RD - STATESVILLE NC 28677

LOCATION SCOTTS CREEK - TL MILLER FARM - TR DOE - TR DEERCROFT - ON RT

SUBDIVISION DEERCROFT BLOCK / SECTION 4 LOT 199 LOT AREA .16AC SITE CLASS. PS DESIGN FLOW 360GPD L.T.A.R. .36GPD/FT²

Septic Tank: 1000 Gallons; STB 1012 Date 8-29-00
Pump Tank: 1000 Gallons; PT 17 Date 4-24-00
Pump Make: GOULDS Model WE0311M Serial No. 00039324
Nitrification Field: No Fields 1 Square Feet 1200 Linear Feet 400
No Lines 4@100' Trench Width 36" Max Trench Bottom Depth 36" Gravel Depth 12"

☑ New System ☐ Repair System Type: I, II, (III), IV, V, VI
System Description: PUMP CONVENTIONAL
Repair System Description: PUMP 25% REDUCTION
Maintenance Agreement Required: ☐ Yes ☑ No
☐ Slab ☑ Crawl Space ☐ Basement w/plumbing ☐ Basement wo/plumbing


☑ House/Mod. Home No. Bedrooms 3
☐ Mobile Home No. Bathrooms 2
☐ Business No. Employees
☐ Other

Water Supply: ☐ Individual ~~☑ Public~~ ☐ Community


Comments:/Conditions:

Comments:/Conditions: (3) SEPTIC TANK W/ RISERS INSTALLED
USING "POLY LOK" FILTER - (2) SYSTEM
PRESSURES CHECKED O.K. 10-20-2000
(3) Electronic Alarm, Riser OKay 2/13-2001

INITIAL SITE SKETCH 1" = 50'

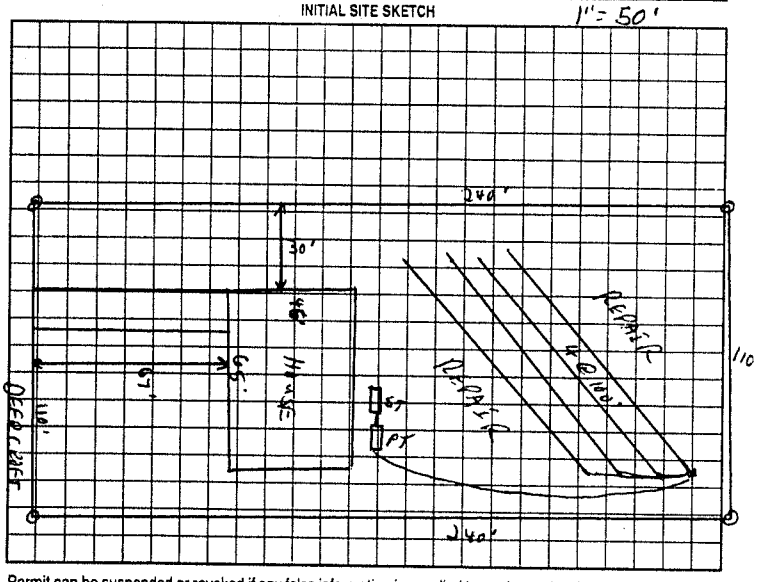

AS BUILT SKETCH

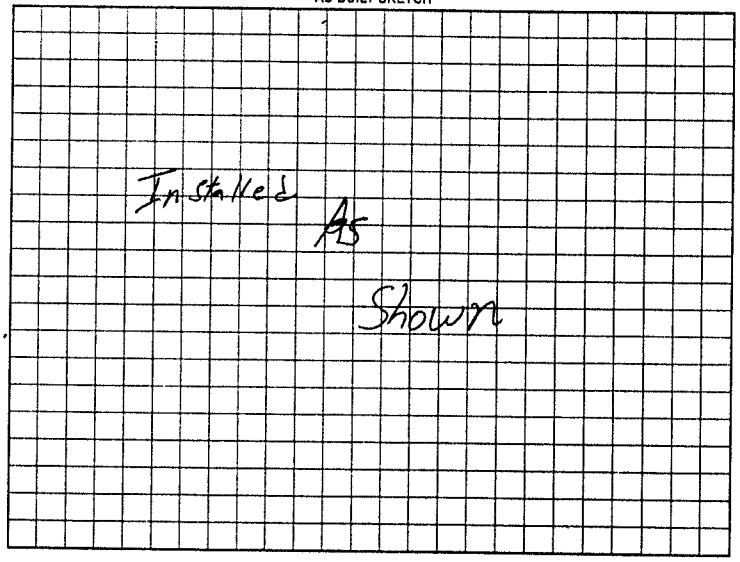

Permit can be suspended or revoked if any false information is supplied toward securing the permit/any unauthorized changes are made to the site/any unauthorized changes are made in the installation of the system. Improvement Permit with plat valid without expiration. Improvement Permit with site plan valid for sixty months. Authorization to Construct is valid for a period equal to that of Improvement Permit – not to exceed sixty months.

Signed: David L. Wh date 7-6-00 Installed by: Steve Jordan

Improvement Permit by: C. Hyatt RS date 7/5/00 Operation Permit by: William C. Johnson date 2/13/01

Authorization to Construct by: C. Hyatt RS date 7/5/00 Existing System Inspection by: date

HEALTH DEPT. COPY: WHITE OWNER COPY (FINAL): YELLOW OWNER COPY (INITIAL): PINK