IREDELL COUNTY HEALTH DEPARTMENT

STATESVILLE 704-878-5305 MOORESVILLE 704-664-5281

IMPROVEMENT PERMIT / AUTHORIZATION TO CONSTRUCT / OPERATION PERMIT / EXISTING SYSTEM INSPECTION

PERMIT# 89735 PIN# 4726 31 6491 (PT) DATE 6-12-00

OWNER OR CONTRACTOR R & L CONSTRUCTORS PHONE: Business Home

ADDRESS 289 SHARON SCH. ROAD, STATESVILLE, NC 28677

LOCATION MILLER FARM ROAD TO DOE TRAIL, TR DEERCROFT DRIVE 3RD LOT BEFORE END ON RIGHT

SUBDIVISION DEERCROFT BLOCK / SECTION IV LOT 197 LOT AREA 0.6066 ACRE SITE CLASS. PS DESIGN FLOW 360 L.T.A.R. 0.30 GPD/FT²

Septic Tank: 1000 Gallons; STB 1012 Date 8-23-00
Pump Tank: Gallons; PT Date
Pump Make: Model Serial No.
Nitrification Field: No Fields 1 Square Feet 60 to 1/250 Linear Feet 300'+
No Lines SIX Trench Width 36" Max Trench Bottom Depth 36" Depth SAND 6"

☑ New System ☐ Repair System Type: I, II, (III), IV, V, VI
System Description: 25% REDUCTION SYSTEM
Repair System Description: ~~CONVENTIONAL~~ PUMP
Maintenance Agreement Required: ☐ Yes ☑ No

☑ House/Mod. Home ☐ Mobile Home ☐ Business ☐ Other
No. Bedrooms 3 No. Bathrooms 2 No. Employees


☐ Slab ☑ Crawl Space ☐ Basement w/plumbing ☐ Basement w/o plumbing

Water Supply: ☐ Individual ☑ Public ☐ Community


Comments/Conditions: INSTALL 25% REDUCTION SYSTEM ON CONTOUR AS SHOWN USING FIFTY (50) CHAMBERS (AT REQUEST)

Comments/Conditions: (1) SYSTEM ALTERED AS SHOWN ARROW WITH PRIOR HEALTH DEPT. APPROVAL DUE TO WIDTH OF DRIVEWAY & 2 CAR GARAGE (2) SEPTIC TANK WITH RISERS INSTALLED USING "POLYLOK" FILTER

INITIAL SITE SKETCH

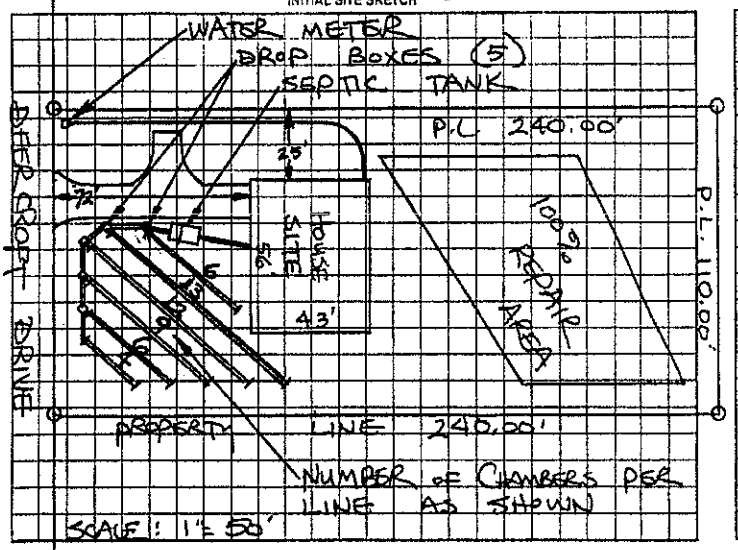

AS BUILT SKETCH

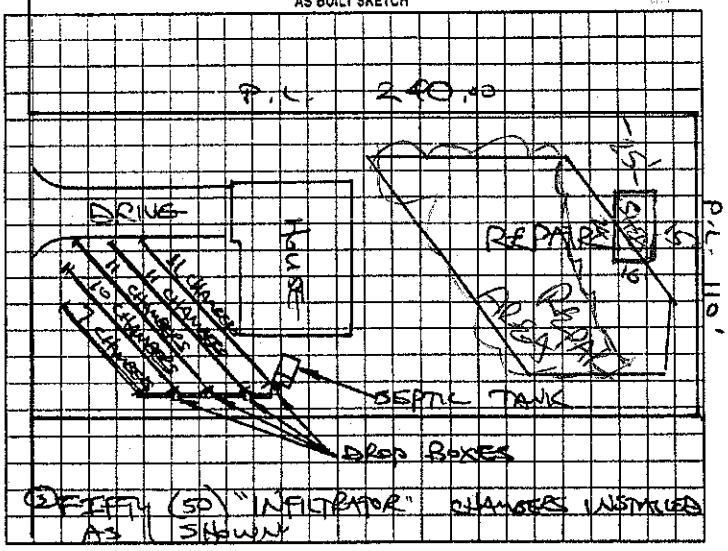

Permit can be suspended or revoked if any false information is supplied toward securing the permit/any unauthorized changes are made to the site/any unauthorized changes are made in the installation of the system. Improvement Permit with plat valid without expiration. Improvement Permit with site plan valid for sixty months. Authorization to Construct is valid for a period equal to that of Improvement Permit – not to exceed sixty months.

Signed: [signature] date 6-13-00 Installed by: STEVE JORDAN

Improvement Permit by: STEVE HEDRICK date 6-12-00 Operation Permit by: STEVE HEDRICK date 10-23-00

Authorization to Construct by: STEVE HEDRICK date 6-12-00 Existing System Inspection by: date

HEALTH DEPT. COPY: WHITE OWNER COPY (FINAL): YELLOW OWNER COPY (INITIAL): PINK

Location of the proposed STORAGE SHED (16'x24') **addition does not appear to impact the existing on-site septic system.**NOTE:** KEEP MIN 5' FROM REPAIR AREA

R. STEVE HEDRICK REHS

Date: APRIL 1, 2013

ICHD-Environmental Health Division

REPAIR AREA CHANGED TO 25% REDUCTION TO ACCOMMODATE STORAGE SHED