IREDELL COUNTY HEALTH DEPARTMENT

STATESVILLE 704-878-5305 MOORESVILLE 704-664-5281

IMPROVEMENT PERMIT / AUTHORIZATION TO CONSTRUCT / OPERATION PERMIT / EXISTING SYSTEM INSPECTION

PERMIT# 83909 PIN# 4726 31 6491 DATE 9-29-99

OWNER OR CONTRACTOR Richard Wilson Jr. PHONE: Business 838-0491 Home

ADDRESS 3325 Winchester Un Sta

LOCATION Scotts creek TL miller Fm TR Dail Tr. TR Deercroft at end

SUBDIVISION Deercroft BLOCK / SECTION 4 LOT 196 LOT AREA .6 SITE CLASS PS DESIGN FLOW 360 L.T.A.R. .3

Septic Tank: 1000 Gallons; STB 1012 Date 10-16-99

Pump Tank: Gallons; PT Date

Pump Make: Model Serial No.

Nitrification Field: No Fields 1 Square Feet 800 Linear Feet 420

No Lines 5 Trench Width 36" Max Trench Bottom Depth 36" Gravel Depth 12"

☑ New System ☐ Repair System Type: I (II) III. IV. V. VI

System Description: Conv. Gravity

Repair System Description: Gravity 25% Reduct.

Maintenance Agreement Required: ☐ Yes ☐ No

☑ House/Mod. Home No. Bedrooms 3

☐ Mobile Home No. Bathrooms 2

☐ Business No. Employees

☐ Other


☐ Slab ☑ Crawl Space ☐ Basement w/plumbing ☐ Basement wo/plumbing

Water Supply: ☐ Individual ☐ Public ☐ Community

Comments:/Conditions:

Comments:/Conditions: SYSTEM INSTALLED ACCORDING TO INITAL SITE SKETCH USING SEPTIC TANK WITH RISERS USING "POLYLOK" FILTER

INITIAL SITE SKETCH

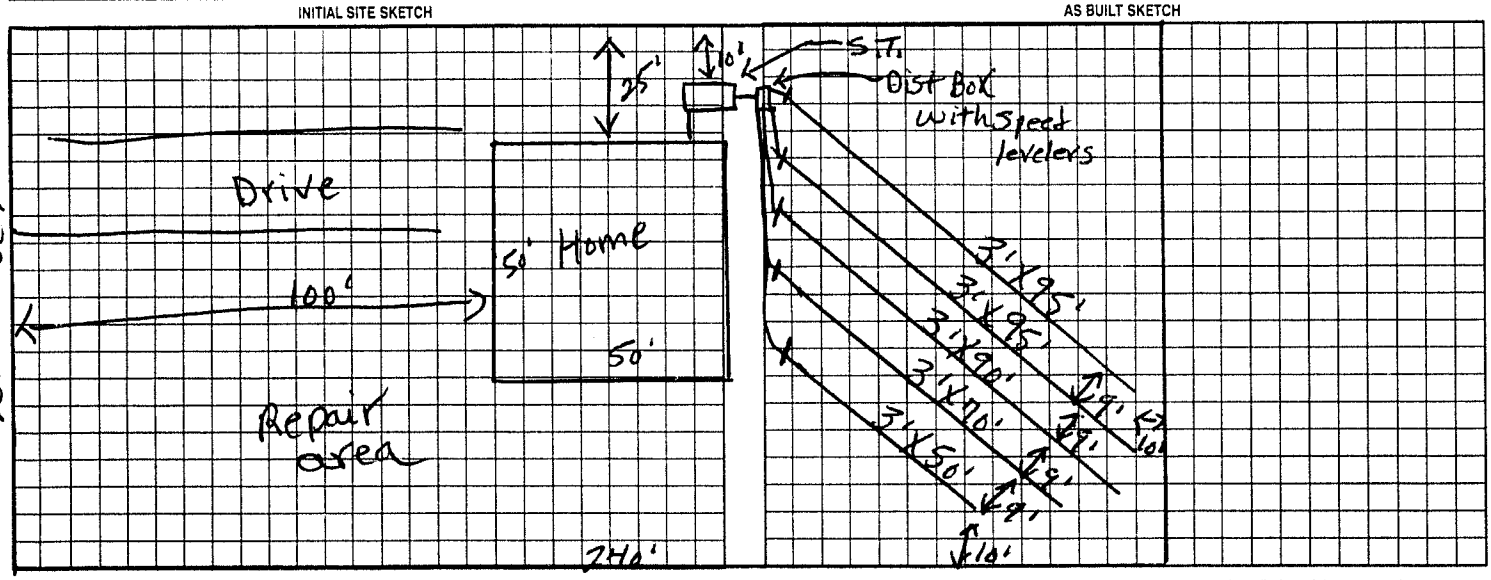

AS BUILT SKETCH

Permit can be suspended or revoked if any false information is supplied toward securing the permit/any unauthorized changes are made to the site/any unauthorized changes are made in the installation of the system. Improvement Permit with plat valid without expiration. Improvement Permit with site plan valid for sixty months. Authorization to Construct is valid for a period equal to that of Improvement Permit – not to exceed sixty months.

Signed: Richard Wilson date Installed by: A-1 BACKHOE

Improvement Permit by: R. C. Moore date 9-29-99 Operation Permit by: STEVE HERRICK date 1-26-00

Authorization to Construct by: R. C. Moore date 9-29-99 Existing System Inspection by: date

HEALTH DEPT. COPY: WHITE OWNER COPY (FINAL): YELLOW OWNER COPY (INITIAL): PINK