IREDELL COUNTY HEALTH DEPARTMENT

STATESVILLE 704-878-5305 MOORESVILLE 704-664-5281

49346

IMPROVEMENT PERMIT / CERTIFICATE OF COMPLETION / OPERATION PERMIT / EXISTING SYSTEM INSPECTION

PROPERTY DESCRIPTION NO. 17429 DATE 11/10/93 TAX MAP NO. 9A-9-A-82

OWNER OR CONTRACTOR KENT & SHERRY NICHOLSON PHONE: Business 876-4359 Home Watershed: ☐ Yes ☑ No

ADDRESS 560 KINGSWOOD DRIVE STATESVILLE NC 28677

LOCATION NC 115 N TL SCOTTS CREEK RD TL MILLER FARM RD TR DOE TRAIL, Lot #82 ON (R) AT NW CORNER OF ELK DR

SUBDIVISION DEERCROFT BLOCK / SECTION II LOT 82 LOT AREA 110' x 200' SITE CLASS. PS DESIGN FLOW 360 L.T.A.R. 0.30 GPD/FT² .4 JCM 12-2-94

Septic Tank: 1000 Gallons; STB 9-4-93 Date

Pump Tank: Gallons; PT 1612 Date

Pump Make: Model Serial No.

Nitrification Field: No Fields 1 Square Feet 900 Linear Feet 300

No Lines 5 Trench Width 36" Max Trench Bottom Depth 18-36" Gravel Depth 12"

☑ New System ☐ Repair System Type: I (II) III, IV, V, VI

System Description: CONVENTIONAL GRAVITY

Repair System Description: CONVENTIONAL GRAVITY

Maintenance Agreement Required: ☐ Yes ☑ No

☑ House/Mod. Home No. Bedrooms 3

☐ Mobile Home No. Bathrooms 2

☐ Business No. Employees

☐ Other


☐ Slab ☑ Crawl Space ☐ Basement w/plumbing ☐ Basement wo/plumbing

Water Supply: ☐ Individual ☐ Community ☑ Public


Comments: (1) KEEP SYSTEM MINIMUM 5' FROM HOUSE, 10' FROM PROPERTY LINE, 10' FROM WATER LINE (2) INSTALL LINES ON CONTOUR, NO DEEPER THAN 36", 9' APART ON CENTER (3) KEEP MINIMUM 15' FROM DRAINAGE DITCH.

Comments:

INITIAL SITE SKETCH

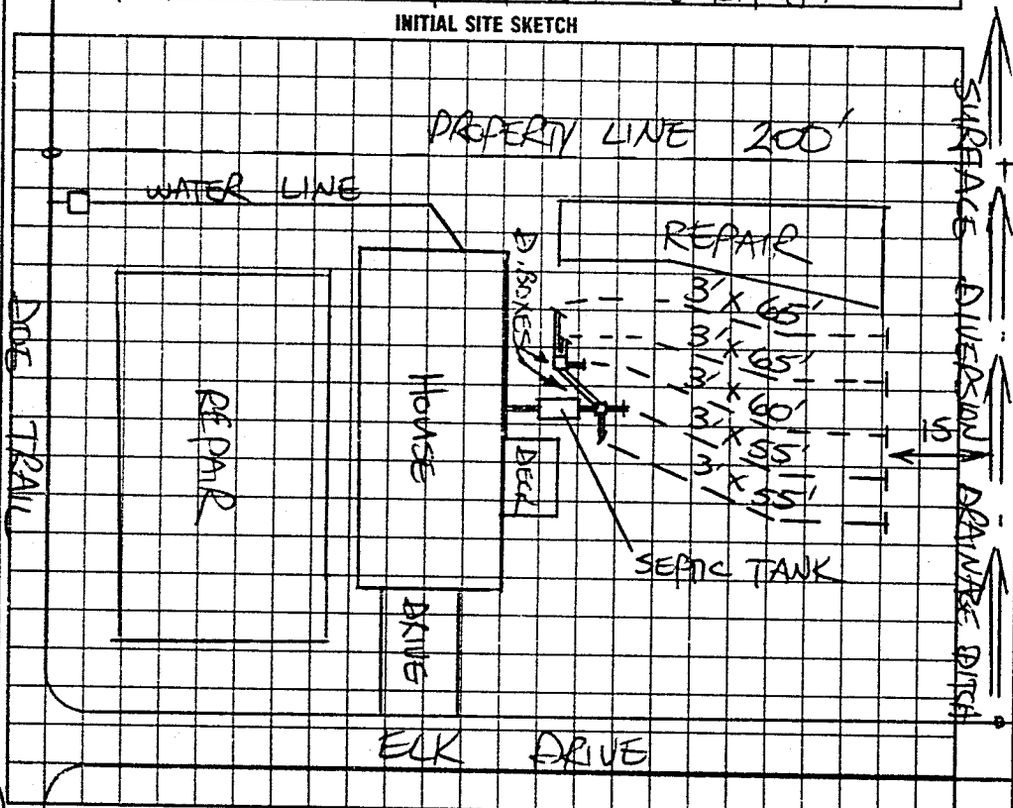

AS BUILT SKETCH

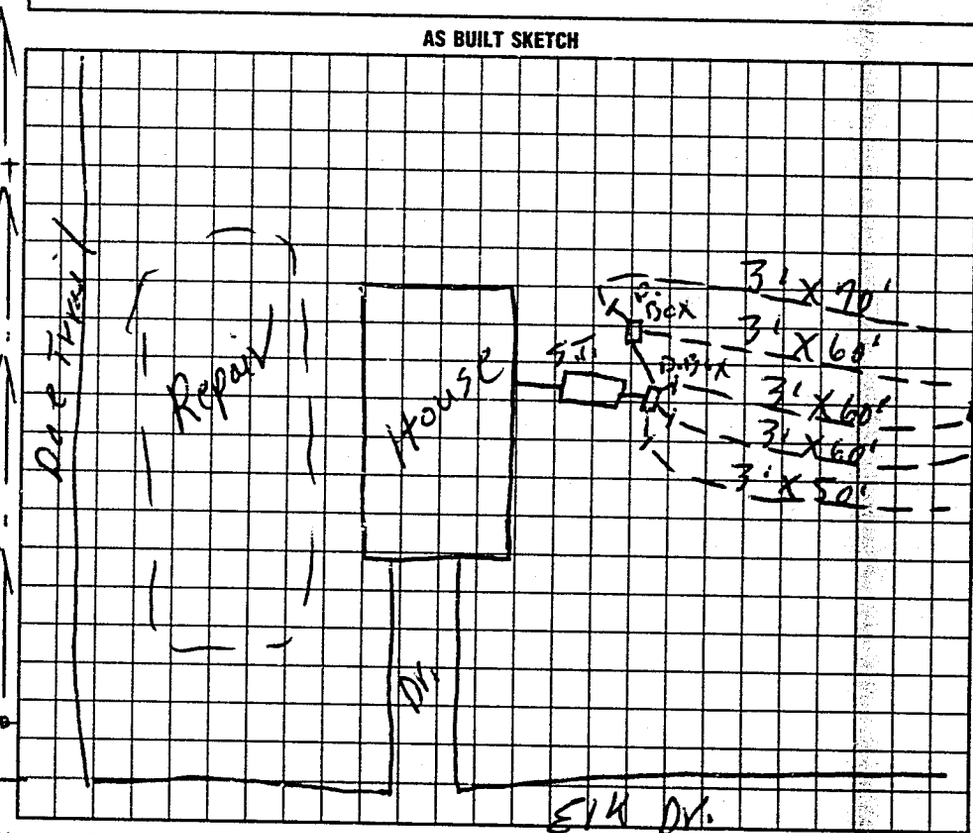

I understand that this permit can be suspended or revoked if any false information is supplied toward securing the permit/any unauthorized changes are made to the site/any unauthorized changes are made in the installation of the system. Improvement Permit is valid for 60 months from date of issuance.

Signed X Kent W Nicholson

Improvement Permit by: STEVE HEDRICK date 11/10/93

Existing System Inspection by: date

Installed by: Tommy Y. Frye

Certificate of Completion by: J. C. Moore date 12-2-94

Operation Permit by: date

HEALTH DEPT. COPY: WHITE INSPECTION COPY (FINAL): GREEN OWNER COPY (FINAL): YELLOW INSPECTION COPY (INITIAL): PINK OWNER COPY (INITIAL): GOLD

18/100