48729

IREDELL COUNTY HEALTH DEPARTMENT

STATESVILLE 704-878-5305 MOORESVILLE 704-664-5281

IMPROVEMENT PERMIT / CERTIFICATE OF COMPLETION / OPERATION PERMIT / EXISTING SYSTEM INSPECTION

PROPERTY DESCRIPTION NO. 16982 DATE 9/13/93 TAX MAP NO. 9A-9-A-109

OWNER OR CONTRACTOR DAN MAHAFFEY PHONE: Business 8761797 Home

ADDRESS RT. 17, BOX 193, STATESVILLE, NC 28677

LOCATION NC 115 N, TL SCOTTS CREEK, TL MILLER FARM, TRADE TRAIL, TREK DR, ON (L), 5TH

SUBDIVISION DEERCROFT BLOCK / SECTION II LOT 109 LOT AREA 110 x 200' SITE CLASS PS L.T.A.R. 0.35 GPD/FT²

Water Supply: ☐ Individual ☐ Community ☑ Public

Septic Tank: 1000 Gallons; STB 1012 Date 9/26/93

Pump Tank: Gallons; PT Date

Nitrification Field: No Fields 1 Square Feet 1035 Linear Feet 345

No Lines 3 Trench Width 36 Trench Depth 18-36 Gravel Depth 12"

☑ New System ☐ Repair System Type: I II III IV V VI

System Description: CONV. GRAVITY

Repair System Description: CONV. GRAVITY

Maintenance Agreement Required: ☐ Yes ☑ No

☑ House/Mod. Home No. Bedrooms 3 Garbage Disposal: ☐ Yes ☑ No

☐ Mobile Home No Bathrooms 2 Auto. Dishwasher: ☑ Yes ☐ No


☐ Business No. Employees Auto. Washing Machine: ☑ Yes ☐ No

☐ Other Other

☐ Slab ☑ Crawl Space ☐ Basement w/plumbing ☐ Basement wo/plumbing

Comments (1) KEEP SYSTEM MINIMUM 5' FROM HOUSE 10' FROM PROPERTY LINE, (2) INSTALL LINES ON CONTOUR, NO DEEPER THAN 36", 9' APART O.C.

INITIAL SITE SKETCH

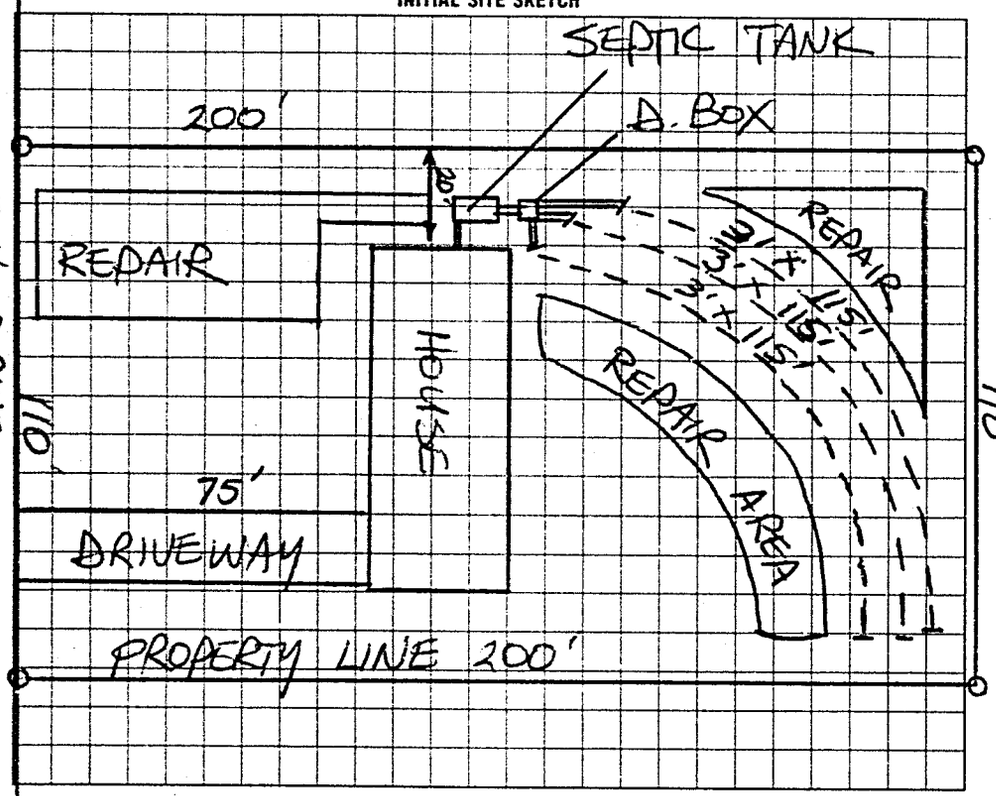

AS BUILT SKETCH

SYSTEM INSTALLED ACCORDING TO INITIAL SITE SKETCH

I understand that this permit can be suspended or revoked if any false information is supplied toward securing the permit/any unauthorized changes are made to the site/any unauthorized changes are made in the installation of the system. Improvement Permit is valid for 60 months from date of issuance.

Signed: X D. Mahaffey

Improvement Permit by: STEVE HEDRICK date 9/13/93

Existing System Inspection by: date

Installed by: JAMES HUDLER

Certificate of Completion by: STEVE HEDRICK date 2/18/94

Operation Permit by: date

HEALTH DEPT COPY: WHITE INSPECTION COPY (FINAL): GREEN OWNER COPY (FINAL): YELLOW INSPECTION COPY (INITIAL): PINK OWNER COPY (INITIAL): GOLD