IREDELL COUNTY HEALTH DEPARTMENT

STATESVILLE 704-878-5305 MOORESVILLE 704-664-5281

IMPROVEMENT PERMIT / CERTIFICATE OF COMPLETION / OPERATION PERMIT / EXISTING SYSTEM INSPECTION

PROPERTY DESCRIPTION NO. 65990 DATE 4-28-97 TAX MAP NO. Pin No. 4726 52 8971 Watershed: ☐ Yes ☑ No

OWNER OR CONTRACTOR W+W Sales PHONE: Business 876-0083 Home

ADDRESS PO Box 5792 Statesville

LOCATION @ miller Em Rd TL Antler Dr. TR Elk Dr. at End

SUBDIVISION Deercroft BLOCK / SECTION LOT 106 LOT AREA .71 Acres SITE CLASS. PS DESIGN FLOW 360 L.T.A.R. .3

Septic Tank: 1000 Gallons; STB 1012 Date 6-27-97

Pump Tank: Gallons; PT Date

Pump Make: Model Serial No.

Nitrification Field: No Fields 1 Square Feet 1200 Linear Feet 400

No Lines 3 Trench Width 36" Max Trench Bottom Depth 36" Gravel Depth 12"

☑ New System ☐ Repair System Type: I, II, III, IV, V, VI

System Description: Conv. Gravity

Repair System Description: " "

Maintenance Agreement Required: ☐ Yes ☑ No

☐ House/Mod. Home No. Bedrooms 3

☐ Mobile Home No. Bathrooms 2

☐ Business No. Employees

☐ Other


☐ Slab ☑ Crawl Space ☐ Basement w/plumbing ☐ Basement wo/plumbing

Water Supply: ☐ Individual ☐ Community ☑ Public


Comments:

Comments:

INITIAL SITE SKETCH

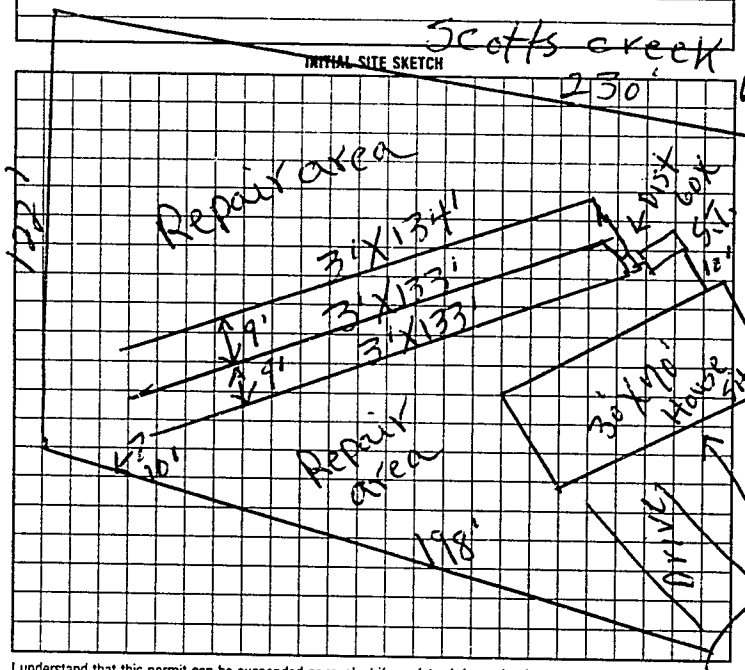

AS BUILT SKETCH

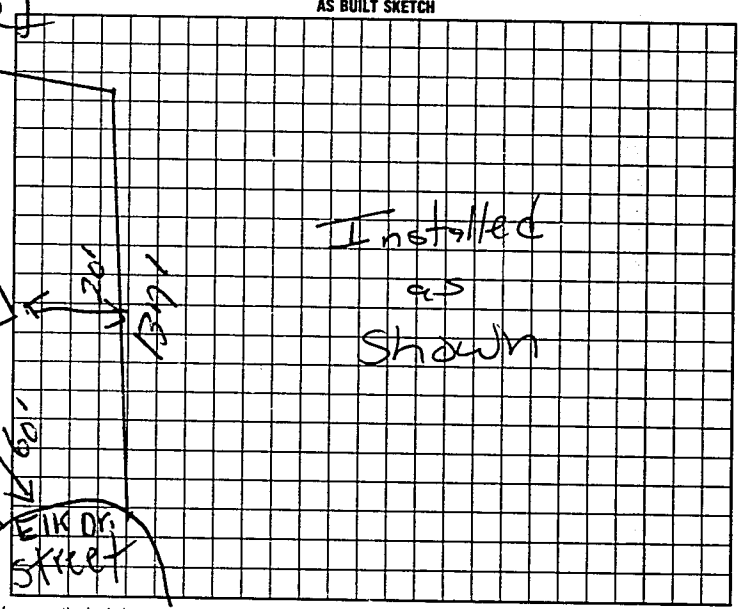

I understand that this permit can be suspended or revoked if any false information is supplied toward securing the permit/any unauthorized changes are made to the site/any unauthorized changes are made in the installation of the system. Improvement Permit is valid for 60 months from date of issuance.

Signed: Ben Yokley

Improvement Permit by: F.C. Moore date 4-28-97

Authorization to Const. Existing System Inspection by: F.C. Moore date 4-28-97

Installed by: David Yountz

Certificate of Completion by: date

Operation Permit by: Max Call RS date 9-3-97

HEALTH DEPT. COPY WHITE — INSPECTION COPY (FINAL) GREEN — OWNER COPY (FINAL) YELLOW — INSPECTION COPY (INITIAL) PINK — OWNER COPY (INITIAL) GOLD

Authorization to Const. Expires 60 mos from issue

0 8 0 2 0 0