**IREDELL COUNTY HEALTH DEPARTMENT - *ENVIRONMENTAL HEALTH*** ☑ STATESVILLE OFFICE 704-878-5305 ☐ MOORESVILLE OFFICE 704-664-5281

**IMPROVEMENT PERMIT / AUTHORIZATION TO CONSTRUCT / OPERATION PERMIT / EXISTING SYSTEM INSPECTION**

PERMIT # 172981 PIN # 4726528971 DATE 6-15-12

OWNER Don Church APPLICANT: Same PHONE: Home/Cell # 704-902-4771 Business # N/A

SITE ADDRESS 170 Elk Dr Statesville NC OWNER / APPLICANT ADDRESS 170 Elk Dr. Statesville NC 28625

SITE DIRECTIONS Miller Farm Rd, Turn Left on Antler Dr. ; R on Elk Dr.

SUBDIVISION Deercroft BLOCK / SECTION N/A LOT # 105 LOT AREA .62 acres DESIGN FLOW 360 gpd. L.T.A.R. 0.25

Septic Tank 1000 (Ex) Gallons: STB 1012 (Ex) Date 6-27-97
Pump Tank ____ Gallons: P T ____ Date ____
Pump Make ____ Model ____ Serial # ____
No. Nitrification Fields: 1 No. Lines 4 Linear Feet 400 (Ex)
Trench Width 36" Max. Trench Bottom Depth 36" Gravel Depth 12"

☑ New System ☐ Repair ☐ Expansion System Type I (II) III IV V VI
System Description: Existing
Repair System Description: 5090 Reduction - Pump
Maintenance Agreement Required ☐ YES ☑ NO
☑ GRAVITY ☐ PRESSURE

☑ Residence No. Bedrooms 3
☐ Business No. Persons ____
☐ Other No. Employees ____
☐ Slab ☑ Crawl Space
☐ Basement w/plumbing ☐ Basement w/o plumbing


Water Supply: ☐ Private ☑ Public ☐ Community

Comments / Conditions

INITIAL SITE SKETCH

New Repair are shown in drawing

AS BUILT SKETCH

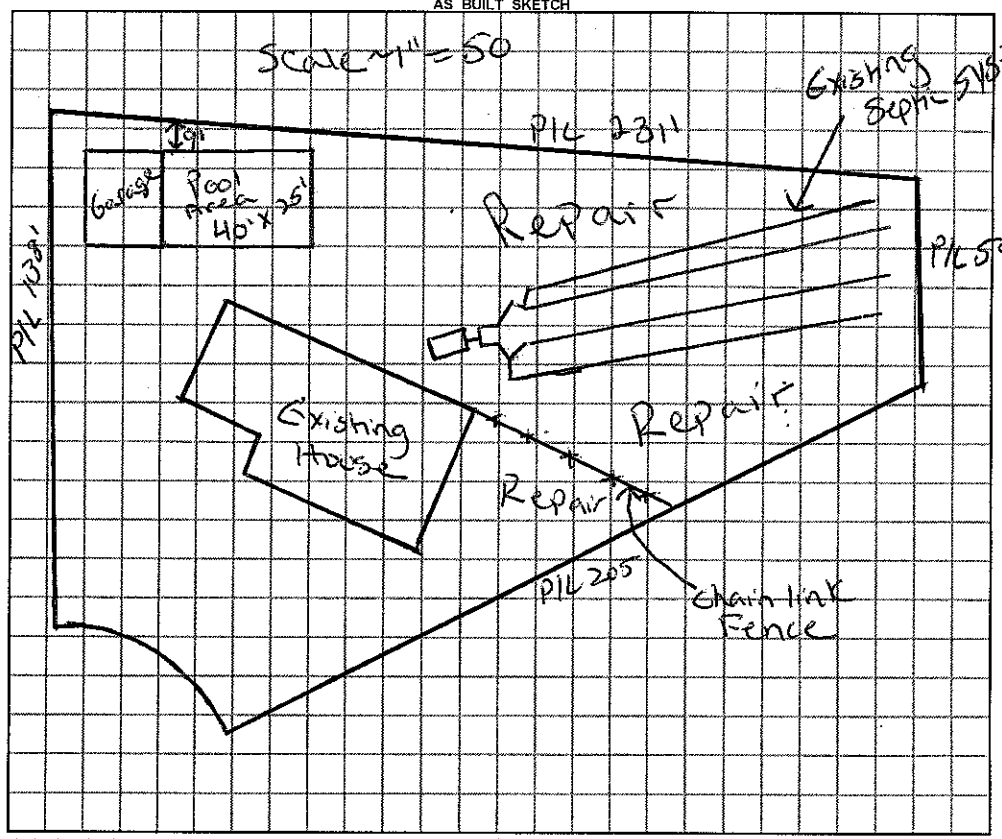


*Permit can be suspended or revoked if any false information is supplied toward securing the permit / any unauthorized changes are made to the site / any unauthorized changes are made in the installation of the system.*

☐ ***IMPROVEMENT PERMIT*** with plat valid without expiration. ☑ ***IMPROVEMENT PERMIT*** with plat ~~valid without expiration~~ site plan valid 60 mo. ☑ ***AUTHORIZATION TO CONSTRUCT*** valid for period equal to IMPROVEMENT PERMIT--not to exceed 60 mo.

Owner / Applicant Signature: [signature] Date 6-15-12 Installed by: ____

IMPROVEMENT PERMIT by: Justin Henderson REHS Date 6-15-12 OPERATION PERMIT by: Justin Henderson REHS Date 6-15-12

AUTHORIZATION TO CONSTRUCT by: Justin Henderson REHS Date 6-15-12 Existing System Inspected by: ____ REHS Date ____

***YOU SHOULD CONTACT A LOCATOR SERVICE PRIOR TO ANY EXCAVATION***

White Copy – Environmental Health YELLOW COPY (Final) Owner / Applicant PINK COPY (Initial) Owner / Applicant