IREDELL COUNTY HEALTH DEPARTMENT

STATESVILLE 704-878-5305 MOORESVILLE 704-664-5281

IMPROVEMENT PERMIT / CERTIFICATE OF COMPLETION / OPERATION PERMIT / EXISTING SYSTEM INSPECTION

PROPERTY DESCRIPTION NO. 65989 DATE 4-28-97 ~~TAX MAP NO.~~ Pin 4726528971 Watershed: ☐ Yes ☐ No

OWNER OR CONTRACTOR WTW Sales PHONE: Business 876 0083 Home

ADDRESS PO Box 5992 Statesville

LOCATION miller Fm Rd TL Antler TR Elk at ent

SUBDIVISION Deercroft BLOCK / SECTION LOT 105 LOT AREA 1.62 SITE CLASS. RS DESIGN FLOW 360 L.T.A.R. 3

Septic Tank: 1000 Gallons; STB 1012 Date 6-29-97

Pump Tank: Gallons; PT Date

Pump Make: Model Serial No.

Nitrification Field: No Fields 1 Square Feet 1200 Linear Feet 400

No Lines 4 Trench Width 36" Max Trench Bottom Depth 36" Gravel Depth 12"

☑ New System ☐ Repair System Type: I, II, III, IV, V, VI

System Description: conv Gravity

Repair System Description: Pump to chambers

Maintenance Agreement Required: ☐ Yes ☑ No

☑ House/Mod. Home No. Bedrooms 3

☐ Mobile Home No. Bathrooms 2

☐ Business No. Employees

☐ Other

☐ Slab ☑ Crawl Space ☐ Basement w/plumbing ☐ Basement wo/plumbing


Water Supply: ☐ Individual ☐ Community ☑ Public

Comments:


Scotts creek RS

Comments:

INITIAL SITE SKETCH

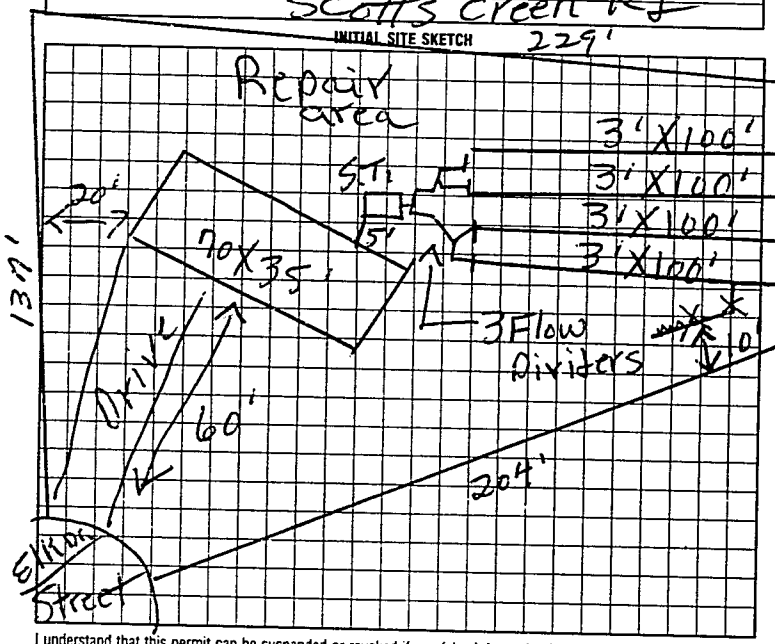

AS BUILT SKETCH

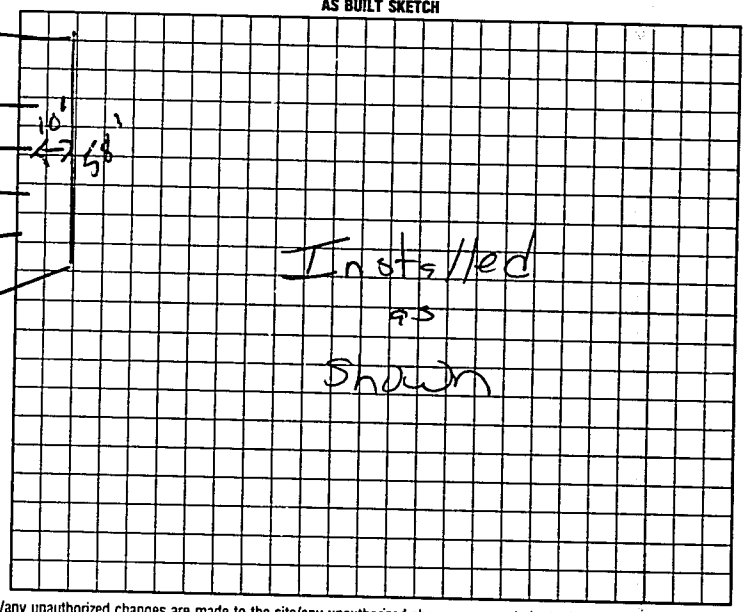

I understand that this permit can be suspended or revoked if any false information is supplied toward securing the permit/any unauthorized changes are made to the site/any unauthorized changes are made in the installation of the system. Improvement Permit is valid for 60 months from date of issuance.

Signed:

Improvement Permit by: L.C. moore date 4-28-97

Existing System Inspection by: L.C. moore date 4-28-97

HEALTH DEPT COPY (WHITE) INSPECTION COPY (FINAL) GREEN OWNER COPY (FINAL) YELLOW

Installed by: David Yantz

Certificate of Completion by: date

Operation Permit by RS date 9-2-97

INSPECTION COPY (INITIAL) PINK OWNER COPY (INITIAL) GOLD

to court. Authorization to Court Expires 6 months from issue

S80E00