IREDELL COUNTY HEALTH DEPARTMENT

48565 9A-9-A-86

STATESVILLE 704-878-5305 MOORESVILLE 704-664-5281

IMPROVEMENT PERMIT / CERTIFICATE OF COMPLETION / OPERATION PERMIT / EXISTING SYSTEM INSPECTION

PROPERTY DESCRIPTION NO. 16855 DATE 8/25/93 TAX MAP NO. 9D-A-18 (86)

OWNER OR CONTRACTOR THOMAS BEATY PHONE: Business 878-2244 ~~Home~~ 871-6947

ADDRESS RT. 2, BOX 91-A CLEVELAND, NC 27013

LOCATION NC115N, TL SCOTTS CREEK, TL MILLER FARM, TR DOE TRAIL, TR ~~ELK~~ DR, TR CARIBOU DR, 2ND LOT ON (R)

SUBDIVISION DEERCROFT BLOCK / SECTION II LOT 86 LOT AREA 110'x200' SITE CLASS PS L.T.A.R.

Water Supply: ☐ Individual ☐ Community ☑ Public

Septic Tank: 1000 Gallons: STB 1012 Date 11-24-93

Pump Tank: Gallons: PT Date

Nitrification Field: No Fields 1 Square Feet 1035 Linear Feet 345

No Lines 4 Trench Width 36" Trench Depth 14-36" Gravel Depth 12"

☑ New System ☐ Repair System Type: I (II) III IV V VI

System Description: CONV. GRAVITY

Repair System Description: CONV. GRAVITY

Maintenance Agreement Required: ☐ Yes ☑ No

☑ House/Mod. Home No. Bedrooms 3

☐ Mobile Home No. Bathrooms 2

☐ Business No. Employees

☐ Other

Garbage Disposal: ☐ Yes ☑ No

Auto. Dishwasher: ☑ Yes ☐ No


Auto. Washing Machine: ☑ Yes ☐ No

Other

☐ Slab ☑ Crawl Space ☐ Basement w/plumbing ☐ Basement wo/plumbing

Comments ① KEEP SYSTEM MINIMUM 5' FROM HOUSE, 10' FROM PROPERTY LINE ② INSTALL LINES ON CONTOUR, NO DEEPER THAN 36", 9' APART ON CENTER

INITIAL SITE SKETCH

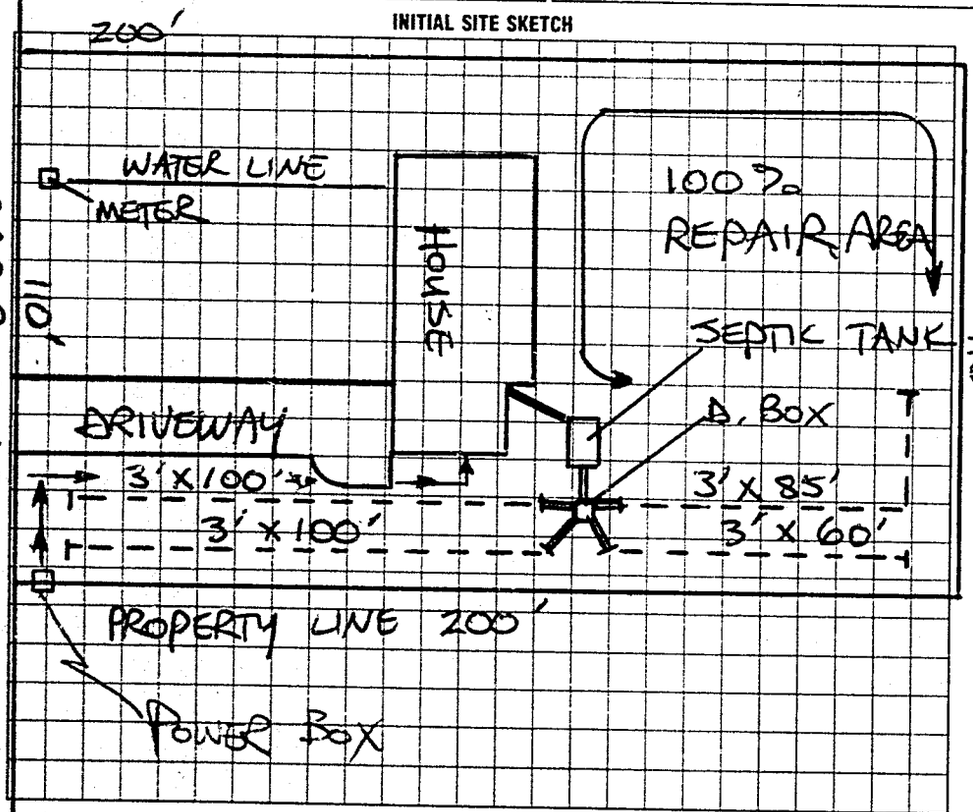

AS BUILT SKETCH

SYSTEM INSTALLED ACCORDING TO INITAL SITE SKETCH

TRENCH POWER LINE IN BETWEEN SEPTIC LINE AND HOUSE / ~~DRIVEWAY~~.

I understand that this permit can be suspended or revoked if any false information is supplied toward securing the permit/any unauthorized changes are made to the site/any unauthorized changes are made in the installation of the system. Improvement Permit is valid for 60 months from date of issuance.

Signed: X Bruce Beaty

Improvement Permit by: STEVE HEDRICK date 8/25/93

Existing System Inspection by: date

Installed by: TOMMY FRYE

Certificate of Completion by: STEVE HEDRICK date 2/3/94

Operation Permit by: date

HEALTH DEPT. COPY WHITE INSPECTION COPY (FINAL) GREEN OWNER COPY (FINAL) YELLOW INSPECTION COPY (INITIAL) PINK OWNER COPY (INITIAL) GOLD