IREDELL COUNTY HEALTH DEPARTMENT

Statesville Office (704) 878-5305 Mooresville Office (704) 660-3625 PERMIT # 222894

IMPROVEMENT PERMIT / AUTHORIZATION TO CONSTRUCT / OPERATION PERMIT / EXISTING SYSTEM

PIN # 4726-52-9619

APPLICANT: Marvin L. Boyer APPLICANT ADDRESS: 160 Elk Drive Statesville NC 28625

SITE ADDRESS: 160 Elk Drive Statesville, NC 28625 PHONE: 765-586-2121 ALT. PHONE:

SITE DIRECTIONS: Rt 115 N from Statesville → L on Scotts Creek Rd → L on Miller Farm Rd → R on Doc Trail Lane → R on Elk Drive → House is towards end on R.

SUBDIVISION: Deercroft @ Granville Grant SECTION: LOT # 103 LOT AREA: 0.51 acres DESIGN FLOW: 360 GPD L.T.A.R.: 0.30 (Ex)

Septic Tank 1000 (Replace) (gal) STB 760 Date 8-6-16
Pump Tank — (gal) PT — Date —
Pump Make — Model — Serial # —
Nitrification Fields 1 (Ex) # Lines 5 (Ex) Linear Ft: 400 (Ex)
Trench Width (Ex) Max. Trench Bottom Depth (Ex) Gravel Depth (Ex)


☐ New System ☒ Repair ☐ Expansion System Type: I (II) III IV V VI
System Description: Replace septic tank as requested.
Repair System Description: Existing (Conv. Gravity)
Maintenance Agreement Required: ☐ YES ☒ NO
☒ GRAVITY ☐ PRESSURE

☒ Residence No. Bedrooms 3
☐ Business No. Persons 6
☐ Other No. Employees
☐ Slab ☒ Crawl Space
☐ Basement w/plumbing ☐ Basement w/o plumbing

Water Supply: ☐ Private ☒ Public ☐ Community

Comments / Conditions: Existing Drainfield location, size + orientation taken from ICHD Permit # 123630 (Dated 9-28-2014). Existing tank to be pumped, limed and crushed in place. New tank to maintain greatest offset as possible from adjacent deck piers/footings. Recommend removing/relocating deck at least 5' from all septic components. Recommend pumping septic tank every 3-5 years.

INITIAL SITE SKETCH

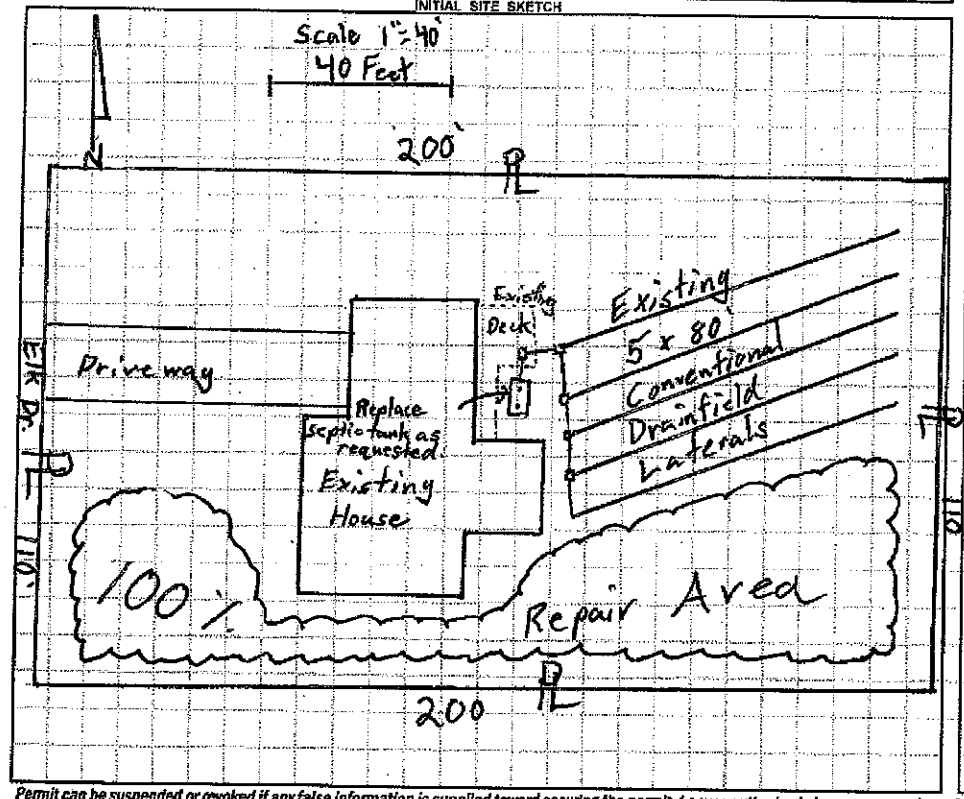

AS BUILT SKETCH

Permit can be suspended or revoked if any false information is supplied toward securing the permit / any unauthorized changes are made to the site / any unauthorized changes are made in the installation of the system. CONTACT A LOCATOR SERVICE PRIOR TO ANY EXCAVATION

☐ IMPROVEMENT PERMIT with plat valid without expiration. ☒ IMPROVEMENT PERMIT with site plan valid for 60 mos. ☒ AUTHORIZATION TO CONSTRUCT valid for period equal to IMPROVEMENT PERMIT--not to exceed 60 mo.

Owner / Applicant Signature: Date: 11-8-2016 Installed by: Hentz Wastewater

IMPROVEMENT PERMIT by: Sam Shuler Date: 11-7-2016 OPERATION PERMIT by: Wesley Sparks Date:

AUTHORIZATION TO CONSTRUCT by: Sam Shuler Date: 11-7-2016 Existing System Inspected by: Date:

Health Dept. Copy - WHITE Applicant (Final Approval) - YELLOW Applicant (Conditional Approval) - PINK