IREDELL COUNTY HEALTH DEPARTMENT

STATESVILLE 704-878-5305 (a1) MOORESVILLE 704-664-5281

IMPROVEMENT PERMIT / AUTHORIZATION TO CONSTRUCT / OPERATION PERMIT / EXISTING SYSTEM INSPECTION

(1)

PERMIT# 123630 PIN# 4726-52-9619 DATE 9-28-04

OWNER OR CONTRACTOR GERALD RIMMER CONSTRUCTION PHONE: Business 704-902-1080 Home 704-528-5724

ADDRESS P.O. BOX 582 TROUTMAN NC 28166

LOCATION NC115 N, TL SCOTTS CREEK, TL MILLER FARM, TR DOE TRAIL, TR ELK DR, LOT AT END ON RIGHT

SUBDIVISION DEERCROFT BLOCK / SECTION II LOT 103 LOT AREA 0.51 ACRE SITE CLASS. PS DESIGN FLOW 360 L.T.A.R. 0.30 GAD/FT

Septic Tank: EXISTING Gallons: STB ____ Date ____

Pump Tank: ____ Gallons: PT ____ Date ____

Pump Make: ____ Model ____ Serial No. ____

Nitrification Field: No Fields 1 Square Feet ____ Linear Feet EXISTING

No Lines FIVE Trench Width ____ Max Trench Bottom Depth ____ Gravel Depth ____

☑ New System ☐ Repair System Type: I, II, III, IV, V, VI

System Description: CONVENTIONAL, GRAVITY

Repair System Description: CONVENTIONAL, GRAVITY

Maintenance Agreement Required: ☐ Yes ☑ No

☑ House/Mod. Home No. Bedrooms 3

☐ Mobile Home No. Bathrooms 2

☐ Business No. Employees ____

☐ Other ____


☐ Slab ☑ Crawl Space ☐ Basement w/plumbing ☐ Basement wo/plumbing

Water Supply: ☐ Individual ☑ Public ☐ Community


Comments:/Conditions: RELOCATE EXISTING SUPPLY LINE AS SHOWN, MINIMUM 5' FROM NEW SUN ROOM FOUNDATION, USING FOUR (4) NEW DROP BOXES FEEDING SERIALLY AS SHOWN.

Comments:/Conditions:

INITIAL SITE SKETCH

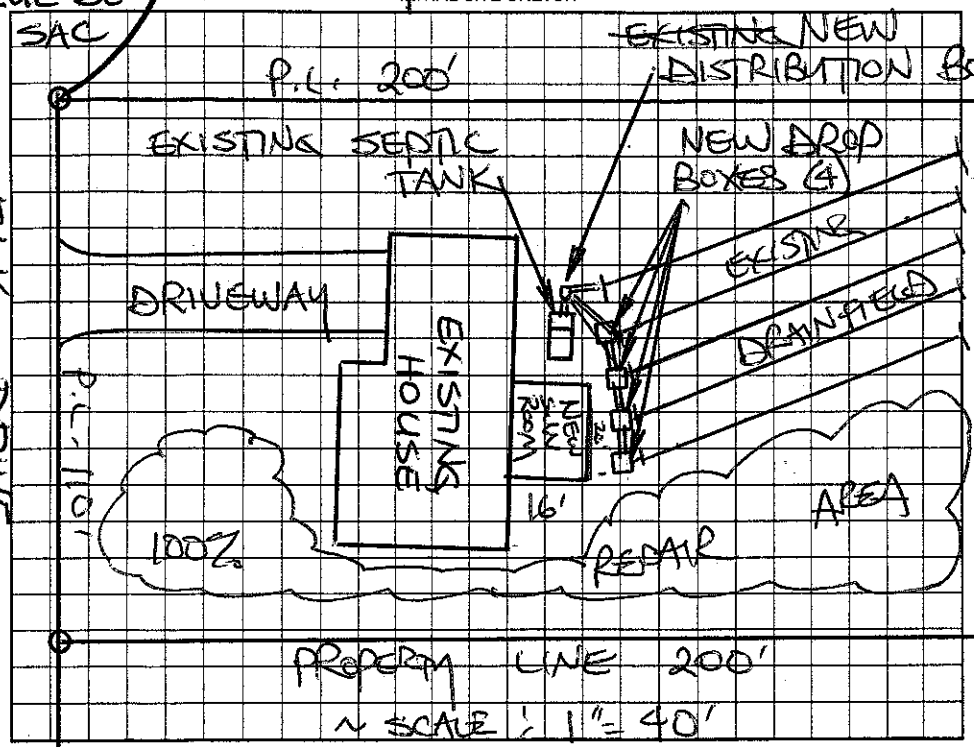

AS BUILT SKETCH

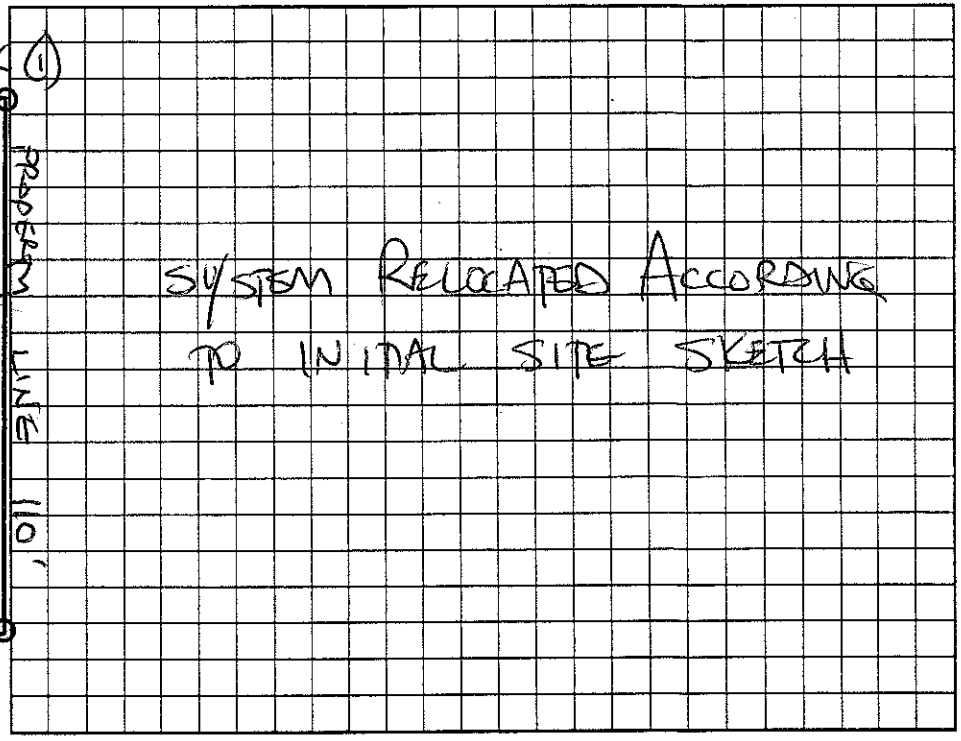

Permit can be suspended or revoked if any false information is supplied toward securing the permit/any unauthorized changes are made to the site/any unauthorized changes are made in the installation of the system. Improvement Permit with plat valid without expiration. Improvement Permit with site plan valid for sixty months. Authorization to Construct is valid for a period equal to that of Improvement Permit – not to exceed sixty months.

Signed: [signature] date 9-28-04

Improvement Permit by: STEVE HEDRICK date 9-28-04

Authorization to Construct by: STEVE HEDRICK date 9-28-04

Installed by: PIEDMONT BACKHOE

Operation Permit by: STEVE HEDRICK date 10-18-04

Existing System Inspection by: ____ date ____

HEALTH DEPT. COPY: WHITE OWNER COPY (FINAL): YELLOW OWNER COPY (INITIAL): PINK