IREDELL COUNTY HEALTH DEPARTMENT

STATESVILLE 704-878-5305 MOORESVILLE 704-664-5261

57585

IMPROVEMENT PERMIT / CERTIFICATE OF COMPLETION / OPERATION PERMIT / EXISTING SYSTEM INSPECTION

PROPERTY DESCRIPTION NO 22030 DATE 9-7-95 TAX MAP NO 9A-4-A-103 Watershed: Yes No

OWNER OR CONTRACTOR HELMAN CONSTRUCTION Phone: Business Home 878-6484

ADDRESS 186 KNOX FARM RD STATESVILLE, NC 28677

LOCATION NC 115 N TO SCOTTS CREEK, L' MILLER FARM, TR' DOE TRAIL, TR ELK DRIVE, ATOMA ON RIGHT

SUBDIVISION DEERCROFT BLOCK SECTION II LOT 103 LOT AREA 110 x 200 SITE CLASS F5 DESIGN FLOW 360 L.T.A.R. 0.3 GPD/SF

Septic Tank 1000 Sketch Site Plan Yes No Date 12-22-95

Pump Tank Size Ref

Pump Make Model

Pressurization Equipment Supplied Square Feet 1250 400

No Lines 5 Trench Width 36 Trench Depth 18 36 Rock Depth 12"

New System Repair System Type I Or II A B

System Description CONVENTIONAL GRAVITY

Repair System Description CONV. GRAVITY

Maintenance Agreement Required Yes No

House/Mobil Home No. Bedrooms 3

Mobile Home No. Bathrooms 2

Business No. Employees

Other


Slab Crawl Space Basement w/plumbing Basement w/o plumbing

Water Supply: Individual Community Public

Comments: KEEP SYSTEM MINIMUM 5' FROM HOUSE, 10' FROM PROPERTY LINE & INSTALL LINES ON CONTOUR, NO DEEPER THAN 36", 9' O.C

Comments

INITIAL SITE SKETCH

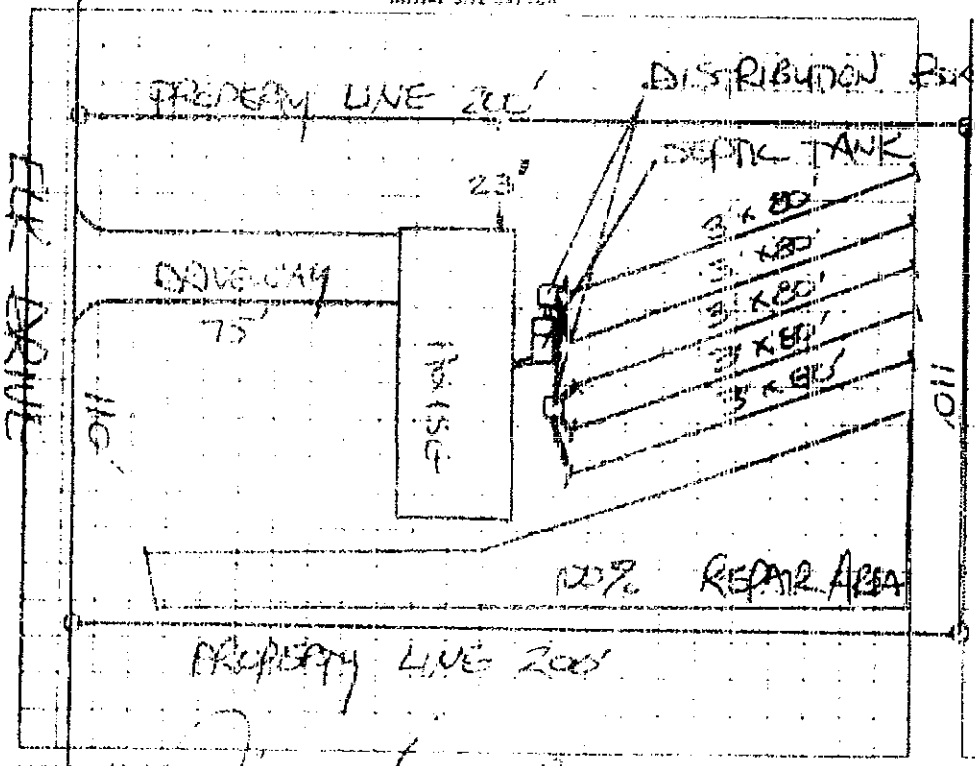

AS BUILT SKETCH

SYSTEM INSTALLED ACCORDING TO INITIAL SITE SKETCH

Signed X Steve Hedrick Date 9-7-95

Improvement Permit

Existing System Inspection

Installed by Andy Yount

Certificate of Completion by Steve Hedrick date 3-1-96

Inspection Made by date

JAN. 8, 1989 0:59