54310

IREDELL COUNTY HEALTH DEPARTMENT

THIS PERMIT VOIDS PREVIOUS ISSUED 1/25/95

STATESVILLE 704-878-5305 MOORESVILLE 704-664-5281

IMPROVEMENT PERMIT / CERTIFICATE OF COMPLETION / OPERATION PERMIT / EXISTING SYSTEM INSPECTION

PROPERTY DESCRIPTION NO. 20177 DATE 2/6/95 TAX MAP NO. 9A-9-A-104 Watershed: ☐ Yes ☑ No

OWNER OR CONTRACTOR JOHN'S WELDING, INC. PHONE: Business Home 873-7885

ADDRESS 1516 MOCKSVILLE HWY STATESVILLE, NC 28677

LOCATION NC 115N TL SCOTTS CREEK, TL MILES FARM, TR BOG TRAIL, TR ELK DRIVE, AT END ON RIGHT

SUBDIVISION DEERCROFT BLOCK / SECTION II LOT 104 LOT AREA 0.5 AC SITE CLASS. B3 DESIGN FLOW 360' L.T.A.R. 0.336 GPD/FT²

Septic Tank: 1000 Gallons; STB 794 Date 2/1/95

Pump Tank: _____ Gallons; PT _____ Date _____

Pump Make: _____ Model _____ Serial No. _____

Nitrification Field: No Fields 1 Square Feet 1080 Linear Feet 360

No Lines 6 Trench Width 36" Max Trench Bottom Depth 18-30" Gravel Depth 12"

☑ New System ☐ Repair System Type: I, II, III, IV, V, VI

System Description: CONV. GRAVITY

Repair System Description: CONV. GRAVITY

Maintenance Agreement Required: ☐ Yes ☑ No

☑ House/Mod. Home No. Bedrooms 3

☐ Mobile Home No. Bathrooms 2

☐ Business No. Employees ____

☐ Other _____


☐ Slab ☑ Crawl Space ☐ Basement w/plumbing ☐ Basement wo/plumbing

Water Supply: ☐ Individual ☐ Community ☑ Public


Comments:

Comments:

INITIAL SITE SKETCH

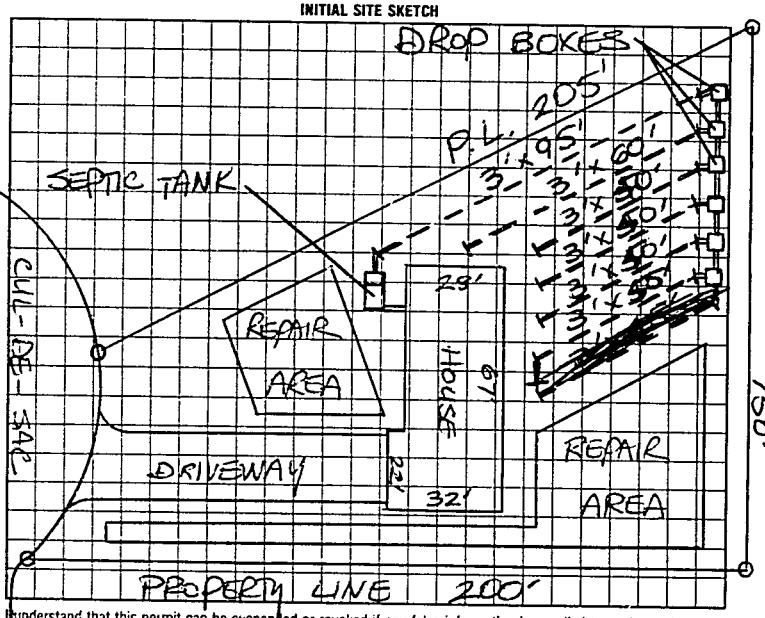

AS BUILT SKETCH

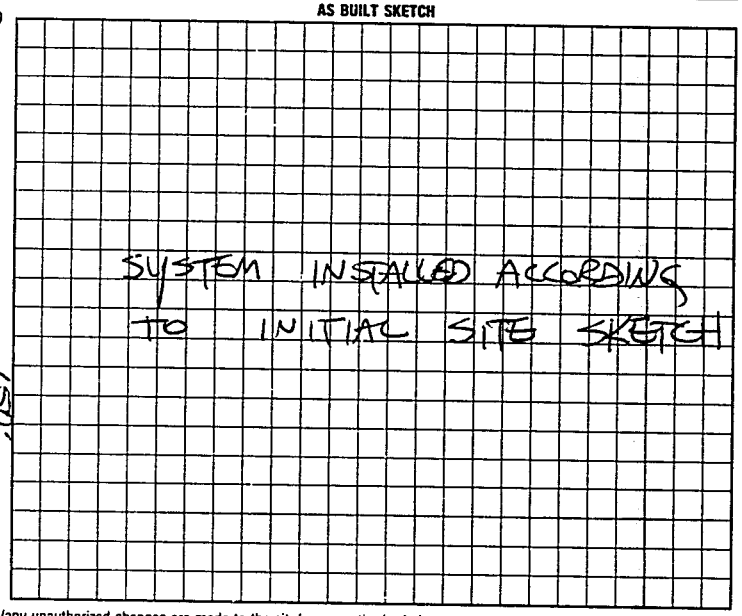

I understand that this permit can be suspended or revoked if any false information is supplied toward securing the permit/any unauthorized changes are made to the site/any unauthorized changes are made in the installation of the system. Improvement Permit is valid for 60 months from date of issuance.

Signed: John Mooneyhan

Improvement Permit by: STEVE HEDRICK date 2/6/95

Existing System Inspection by: _____ date _____

Installed by: A-1 BACKHOE

Certificate of Completion by: STEVE HEDRICK date 3/21/95

Operation Permit by: _____ date _____

HEALTH DEPT. COPY: WHITE INSPECTION COPY (FINAL) GREEN OWNER COPY (FINAL). YELLOW INSPECTION COPY (INITIAL). PINK OWNER COPY (INITIAL) GOLD

ELK DRIVE