IREDELL COUNTY HEALTH DEPARTMENT

STATESVILLE 704-878-5305 MOORESVILLE 704-664-5281

IMPROVEMENT PERMIT / CERTIFICATE OF COMPLETION / OPERATION PERMIT / EXISTING SYSTEM INSPECTION

PROPERTY DESCRIPTION NO. 22761 DATE 11-29-95 TAX MAP NO. 9A-9-A-125 Watershed: Yes No

OWNER OR CONTRACTOR KENNETH WATT PHONE: Business Home 876-0047

ADDRESS 129 BECKHAM ROAD, STATESVILLE, NC 28677

LOCATION IREDELL TL SIDE CLOCK TL MILLER FARM, TRANTLER, TL RED BARN TL RIDGEVIEW, AT END ON RIGHT

SUBDIVISION DEERCREST BLOCK / SECTION III LOT 12-5 LOT AREA ~110 x 240' SITE CLASS. DESIGN FLOW 360 L.T.A.R. 0.25 GAD/FT

Septic Tank: 1000 Gallons. STB 1512 Date 12-26-95

Pump Tank: Gallons: PT Date

Pump Make: Model Serial No

Nitrification Field: No Fields 1 Square Feet 1440 Linear Feet 360

No Lines 4 Trench Width 36" Max. trench Bottom Depth 24 - 36" Gravel Depth N/A

☑ New System ☐ Repair System Type: I, II, III, IV

System Description: CHAMBERED GRAVITY

Repair System Description: CHAMBERED GRAVITY

Maintenance Agreement Required: ☐ Yes ☐ No

☑ House/Mod. Home No. Bedrooms 3

☐ Mobile Home No. Bathrooms 2

☐ Business No. Employees

☐ Other


☐ Slab ☑ Crawl Space ☐ Basement w/plumbing ☐ Basement wo/plumbing

Water Supply: ☐ Individual ☐ Community ☑ Public

Comments: ① INSTALL 60 CHAMBERS IN FOUR EQUAL LENGTH LINES ON CONTOUR AT LOCATION SHOWN ② USE THREE FLOW DIVIDER TEES TO ACHIEVE EQUAL DISTRIBUTION INTO EACH OF FOUR LINES AS SHOWN.

Comments:

INITIAL SITE SKETCH

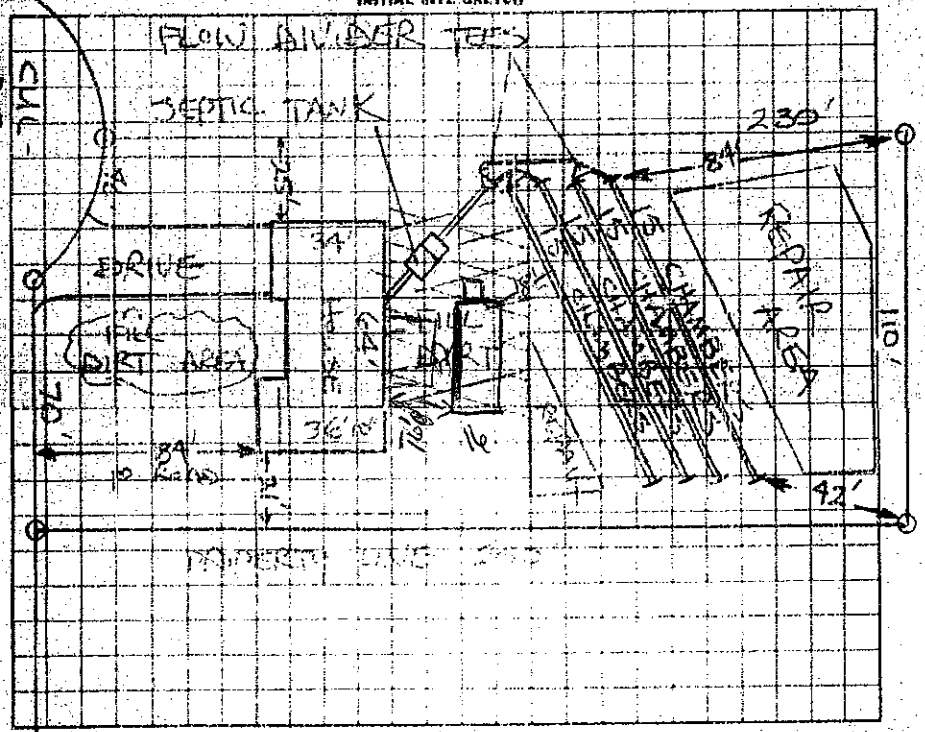

AS BUILT SKETCH

SYSTEM INSTALLED ACCORDING TO INITIAL SITE SKETCH

The proposed / existing inground pool addition does not appear to impact the existing septic system.

**NOTE:

REHS

Date: 3-2-10

ICHD-Environmental Health Division

I understand that this permit can be suspended or revoked if any false information is supplied toward securing the permit/any unauthorized changes are made to the site/any unauthorized changes are made in the installation of the system. AUTHORIZATION TO CONSTRUCT IS VALID FOR FIVE(5) YEARS FROM DATE OF ISSUANCE. IMPROVEMENT PERMIT HAS NO EXPIRATION DATE

Signed: [signature]

Improvement Permit by: STEVE HENRICK date 11-29-95

Authorization to Construct by: STEVE HENRICK date 11-29-95

Existing System Inspection by:

Installed by: DALE FOX

Certificate of Completion by: date

Operation Permit by: STEVE HENRICK date 3-11-96

HEALTH DEPT. COPY: WHITE INSPECTION COPY (FINAL): GREEN OWNER COPY (FINAL): YELLOW INSPECTION COPY (INITIAL): PINK OWNER COPY (INITIAL): GOLD

RIDGEVIEW ROAD

NOV. 4, 1989 13:57