IREDELL COUNTY HEALTH DEPARTMENT

Statesville Office (704) 878-5305 Mooresville Office (704) 660-3625 PERMIT # 232185

SEPTIC IMPROVEMENT PERMIT / AUTHORIZATION TO CONSTRUCT / OPERATION PERMIT / EXISTING SYSTEM

PIN # 4726602090

APPLICANT/OWNER: Peter M. Spirito APPLICANT ADDRESS: 6456 NW Halibut ST Fort Pierce FL 34986

SITE ADDRESS: 150 E. Morrison Creek RD Statesville NC 28625 PHONE: 561-758-1291 ALT. PHONE ~

SITE DIRECTIONS: 115 N L Scotts Creeks (L) Miller Farm (R) Antler (L) E. Morrison. SAP CONTROLLED: [X] YES [ ] NO

SUBDIVISION: Deercroft SECTION: 3 LOT # 149 LOT AREA: 4.08 DESIGN FLOW: 360gpd L.T.A.R.: .30

Septic Tank 1000 (gal) STB 760 Date 5/25/18
Pump Tank 1000 (gal) PT 3603 Date 5/25/18
Pump Make Zoeller Model BN152B Serial # 152-0005
Nitrification Fields 1 # Lines 3 Linear Ft 300
Trench Width 36 Trench Bottom Depth(Low side) 30 Gravel Depth ~

[X] New System [ ] Repair [ ] Expansion System Type: I II (III) IV V VI
System Description: 25% Pressure manifold
Repair System Description: 50% Pump
Maintenance Agreement Required: [ ] YES [X] NO
[ ] GRAVITY [X] PRESSURE

[X] Residence No. Bedrooms 3
[ ] Business No. Persons 6
[ ] Other No. Employees
[ ] Slab [X] Crawl Space
[ ] Basement w/plumbing [ ] Basement w/o plumbing

Water Supply: [ ] Private [X] Public [ ] Community

Comments / Conditions: Install Septic drainlines on the contour of the land and utilize pressure manifold. utilize 1½ Sch40 Tees @ 7-11 ppm for Each Drainline. Dose @ 135gallons 6-3 inch drawdown. TDH to TBD.

2 BR House beig built must install 3 BR system

INITIAL SITE SKETCH

See attached Scaled Drawing provided by Paul Perrigo.

AS BUILT SKETCH

-ST 17' from house

	Date	Initials
Drain Lines Checked	8/6/18	CC
Tanks Checked	8/6/18	CC
Pressure Manifold or Valve Box Checked	8/6/18	CC
Pressure Head Set	8/6/18	CC
Electrical Checked	11/21/18	CC
Floats Set	11/21/18	CC
Alarm Checked	11/21/18	CC
Maintenance Contract Y / (N)	Not Required	

Permit can be suspended or revoked if any false information is supplied toward securing the permit / any unauthorized changes are made to the site / any unauthorized changes are made in the installation of the system. **CONTACT A LOCATOR SERVICE PRIOR TO ANY EXCAVATION**


[ ] **IMPROVEMENT PERMIT** *with plat valid without expiration.* [X] **IMPROVEMENT PERMIT** *with site plan valid for 60 mos.* [ ] **AUTHORIZATION TO CONSTRUCT** *valid for period equal to IMPROVEMENT PERMIT--not to exceed 60 mo.*

Owner / Applicant Signature: [signature] Date: 8/3/18 Installed by: Groundbreakers

IMPROVEMENT PERMIT by: Benjamin A Butler Date: 4/17/2018 OPERATION PERMIT by: Carla C. Cave Date: 11/21/18

AUTHORIZATION TO CONSTRUCT by: Benjamin A Butler Date: 4/17/2018. Existing System Inspected by: Date:

FOR SEPTIC FINAL INSPECTION: CALL 704-664-3703 between 8am-9am the day the inspection is needed. Be sure to speak with an inpsector to confirm your inspection time.

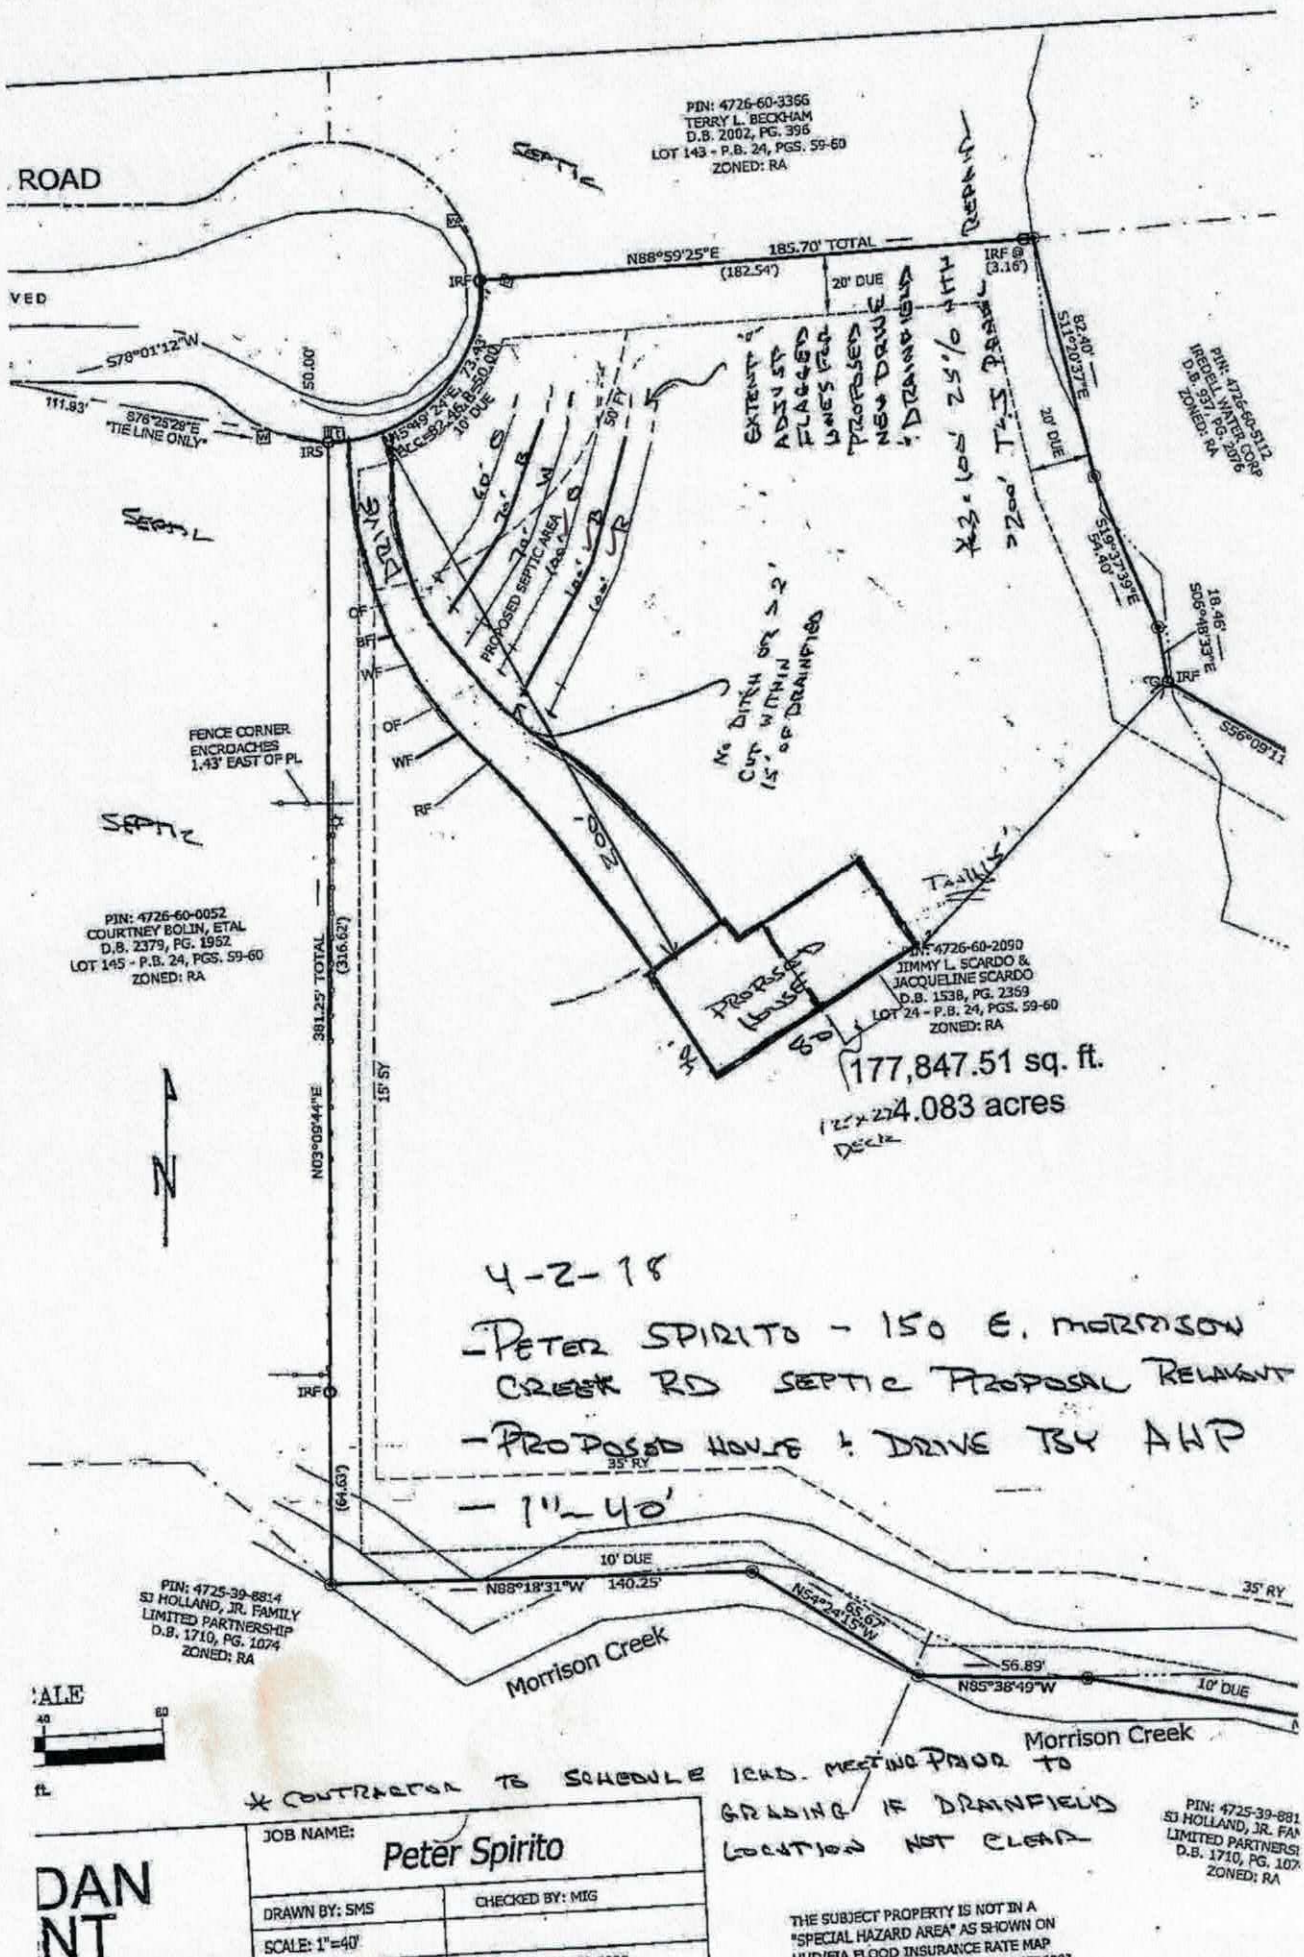
PIN: 4726-60-3356
TERRY L. BECKHAM
D.B. 2002, PG. 396
LOT 143 - P.B. 24, PGS. 59-60
ZONED: RA
ROAD
VED
N88°59'25"E 185.70' TOTAL
(182.54')
20' DUE
IRF
IRF @ (3.16')
S78°01'12"W
50.00'
111.93'
S78°28'29"E
"TIE LINE ONLY"
IRS
N15°49'24"E 73.43'
N/C=S82°46'E=50.00'
10' DUE
S12°20'37"E
82.40'
20' DUE
PIN: 4726-60-5112
IREDELL WATER CORP
D.B. 537, PG. 2076
ZONED: RA
S19°23'39"E
54.40'
S06°48'33"E
18.46'
S56°09'11
EXTENT OF ADVISE FLAGGED LINES FOR PROPOSED NEW DRIVE & DRAINFIELD
+32.10' 25% GRADE
>20' TIES PROP.
PROPOSED SEPTIC AREA
100% RR
40' S
70' R
10' UR
50' R
DRIVE
SEPTIC
OF
BF
WF
RF
FENCE CORNER ENCROACHES 1.43' EAST OF PL
SEPTIC
PIN: 4726-60-0052
COURTNEY BOLIN, ETAL
D.B. 2379, PG. 1952
LOT 145 - P.B. 24, PGS. 59-60
ZONED: RA
381.25' TOTAL
(316.62')
N03°09'44"E
15' SY
IRF
(64.63')
35' RY
10' DUE
N88°18'31"W 140.25'
PIN: 4725-39-8814
SJ HOLLAND, JR. FAMILY
LIMITED PARTNERSHIP
D.B. 1710, PG. 1074
ZONED: RA
Morrison Creek
N54°24'15"W
65.67'
56.89'
N85°38'49"W
10' DUE
35' RY
Morrison Creek
PROPOSED HOUSE
PIN: 4726-60-2090
JIMMY L. SCARDO & JACQUELINE SCARDO
D.B. 1538, PG. 2359
LOT 24 - P.B. 24, PGS. 59-60
ZONED: RA
177,847.51 sq. ft.
4.083 acres
12'x27' Deck
NO DITCH OR > 2' CUT WITHIN 15' OF DRAINFIELD
N
ALE
40 0 40
ft
4-2-18
-PETER SPIRITO - 150 E. MORRISON CREEK RD SEPTIC PROPOSAL RELAVANT
-PROPOSED HOUSE & DRIVE TBV AHP
- 1"=40'
* CONTRACTOR TO SCHEDULE ICHD. MEETING PRIOR TO GRADING IF DRAINFIELD LOCATION NOT CLEAR
JOB NAME: Peter Spirito
DRAWN BY: SMS
CHECKED BY: MIG
SCALE: 1"=40'
PIN NO: 4726-60-2090
THE SUBJECT PROPERTY IS NOT IN A "SPECIAL HAZARD AREA" AS SHOWN ON HUD/FIA FLOOD INSURANCE RATE MAP
PIN: 4725-39-881
SJ HOLLAND, JR. FA
LIMITED PARTNERSI
D.B. 1710, PG. 107
ZONED: RA

DEPARTMENT OF HEALTH AND HUMAN SERVICES
DIVISION OF PUBLIC HEALTH, ENVIRONMENTAL HEALTH SECTION
ON-SITE WATER PROTECTION BRANCH

Z32185

Sheet 1 of 1
PROPERTY ID #: 47266020
COUNTY: Iredell

SOIL/SITE EVALUATION
***for* ON-SITE WASTEWATER SYSTEM**
(Complete all fields in full)

OWNER: Peter Spicito
ADDRESS: Port Saint Lucie FL PO Box 81435
PROPOSED FACILITY: 3BR Home. PROPOSED DESIGN FLOW (.1949): 360 gpd.
LOCATION OF SITE: 150 East Morrison Creek Sub,

APPLICATION DATE 12-8-17.
DATE EVALUATED: 12/29/17
PROPERTY SIZE: 4.08 Acres
PROPERTY RECORDED: Y/N.

WATER SUPPLY: ☐ Private ☑ Public ☐ Well ☐ Spring ☐ Other
EVALUATION METHOD: ☐ Auger Boring ☑ Pit ☐ Cut
TYPE OF WASTEWATER: ☑ Sewage ☐ Industrial Process ☐ Mixed

PROFILE #	.1940 LANDSCAPE POSITION/ SLOPE %	HORIZON DEPTH (IN.)	SOIL MORPHOLOGY (.1941) .1941 STRUCTURE/ TEXTURE	SOIL MORPHOLOGY (.1941) .1941 CONSISTENCE/ MINERALOGY	OTHER PROFILE FACTORS .1942 SOIL WETNESS/ COLOR	.1943 SOIL DEPTH	.1956 SAPRO CLASS	.1944 RESTR HORIZ	PROFILE CLASS & LTAR
1	10%	0-20	SCL WSBK	SS SP FR SEXP		20		Mica Heavy	PS .3.
		20-60	Loamy Sand M	NS NP VFR					
2	10%	0-20	SCL WSBK	SS SP FR SEXP		20		Heavy Mica	PS .3
		20-58	Loamy Sand M	NS NP VFR					
3	10%	0-36	SCL WSBK	SS SP FR SEXP		36		Heavy Mica	PS .3.
		36-58.	Loamy Sand M.	NS NP VFR					
4	10%	0-13	L SBK	SS SP FM SEXP		30.		Heavy Mica.	PS .3.
		13-27	CL WSBK	SS SP FR					
		27-30	Firm						
		30-60	Loamy Sand.	NS NP VFR					

DESCRIPTION	INITIAL SYSTEM	REPAIR SYSTEM
Available Space (.1945)	300	200
System Type(s)	III	IV
Site LTAR	.3	.3.

OTHER FACTORS (.1946): ~
SITE CLASSIFICATION (.1948): PS
EVALUATED BY: Botkins
OTHER(S) PRESENT: P. Pennington

COMMENTS:

LEGEND

use the following standard abbreviations

LANDSCAPE POSITION	GROUP	SOIL TEXTURE	CONVENTIONAL .1955 LTAR*	LPP .1957 LTAR*
CC (Concave Slope) CV (Convex Slope) D (Drainage Way) DS (Debris Slump) FP (Flood Plain) FS (Foot Slope) H (Head Slope) L (Linear Slope) N (Nose Slope) R (Ridge) S (Shoulder Slope) T (Terrace)	I	S (Sand) LS (Loamy Sand)	1.2 - 0.8	0.6 - 0.4
	II	SL (Sandy Loam) L (Loam)	0.8 - 0.6	0.4 - 0.3
	III	Si (Silt) SiCL (Silty Clay Loam) CL (Clay Loam) SCL (Sandy Clay Loam) SiL (Silt Loam)	0.6 - 0.3	0.3 - 0.15
	IV	SC (Sandy Clay) SiC (Silty Clay) C (Clay)	0.4 - 0.1	0.2 - 0.05
		O (Organic)	None	None

MINERALOGY/ CONSISTENCE
SEXP (Slightly Expansive) EXP (Expansive)

STRUCTURE
G (Single Grain) M (Massive) CR (Crumb) GR (Granular) SBK (Subangular Blocky) ABK (Angular Blocky) PL (Platy) PR (Prismatic)

MOIST
VFR (Very Friable) FR (Friable) FI (Firm) VFI (Very Firm v. Very Sticky) EFI (Extremely Firm)

WET
NS (Non-sticky) SS (Slightly Sticky) S (Sticky) VS (Very Sticky) NP (Non-plastic) SP (Slightly Plastic) P (Plastic) VP (Very Plastic)

*Adjust LTAR due to depth, consistence, structure, soil wetness, landscape, position, wastewater flow and quality.


NOTES

HORIZON DEPTH	In inches below natural soil surface
DEPTH OF FILL	In inches from land surface
RESTRICTIVE HORIZON	Thickness and depth from land surface
SAPROLITE	S(suitable) or U(unsuitable)
SOIL WETNESS	Inches from land surface to free water or inches from land surface to soil colors with chroma 2 or less - record Munsell color chip designation
CLASSIFICATION	S (Suitable), PS (Provisionally Suitable), or U (Unsuitable)

*Evaluation of saprolite shall be by pits.

Long-term Acceptance Rate (LTAR): gal/day/ft^2

Show profile locations and other site features (dimensions, reference or benchmark, and North).

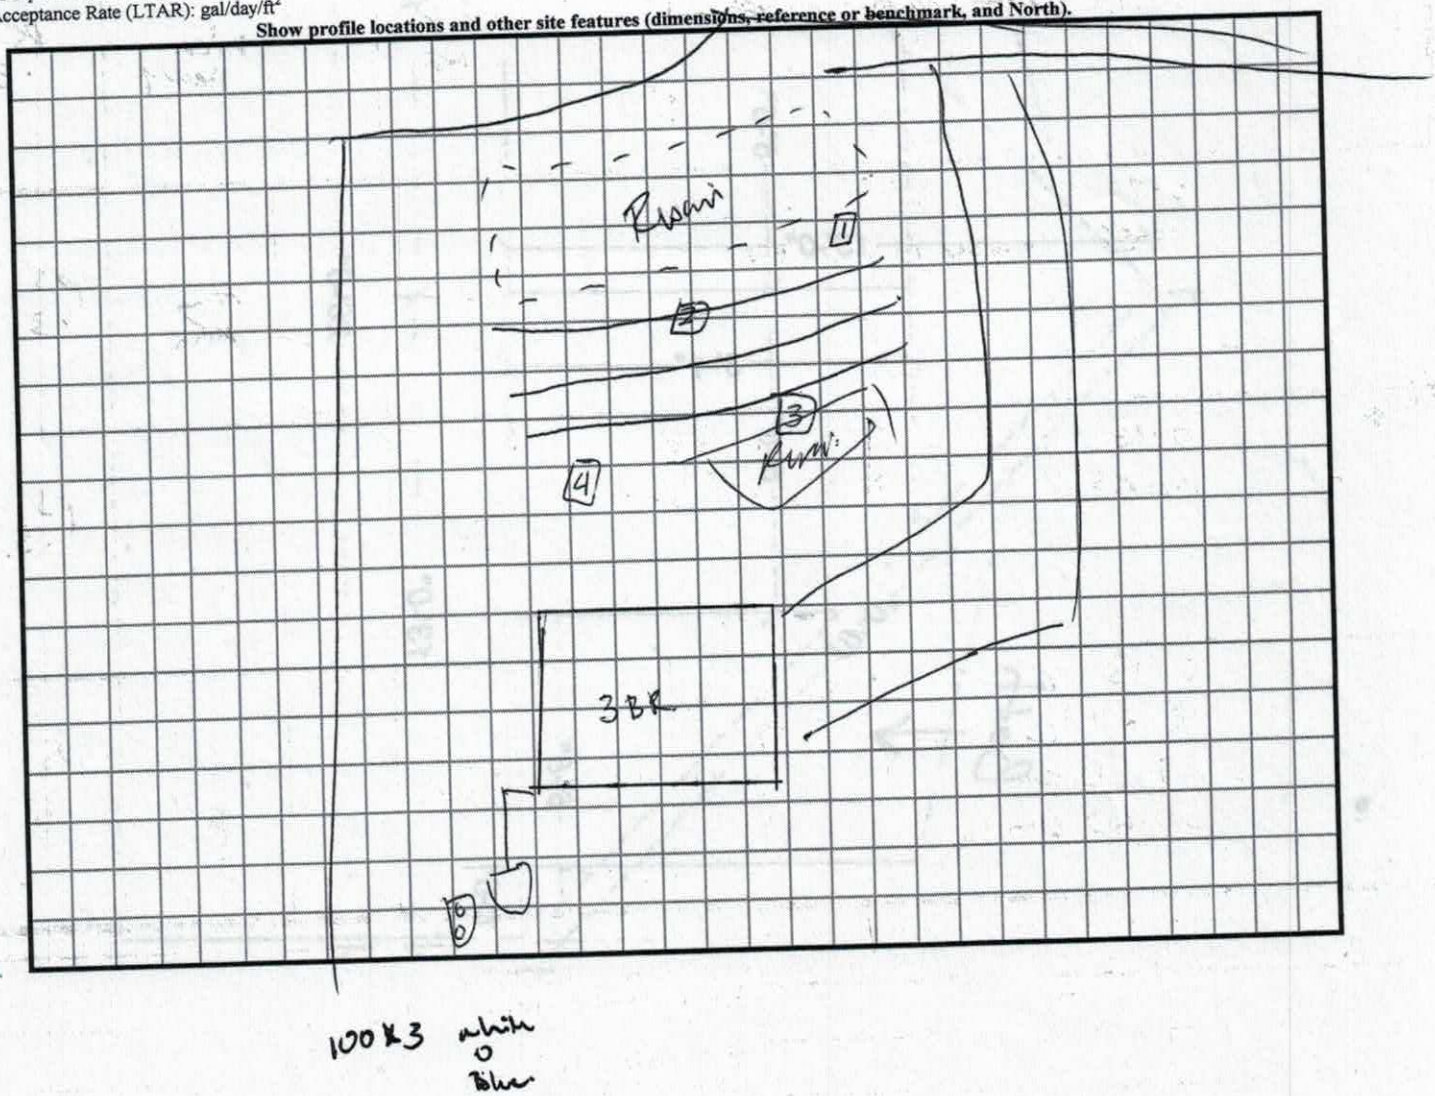

Call Paul Perkins w/ questions 1CHD
Limited Permit #105

IREDELL COUNTY DEPARTMENT of ENVIRONMENTAL HEALTH

704-996-6336

APPLICATION FORM

Application For: ( ) New Well Permit ( ) Well Repair Permit ( ) Well Abandonment
(X) Septic Improvement Permit (X) Authorization to Construct ( ) Existing System Inspection ( ) Septic System Repair

THE ABOVE PERMIT DOCUMENTS WILL BECOME INVALID IF INFORMATION PROVIDED ON THIS APPLICATION IS FALSIFIED OR CHANGED, OR IF THE SITE IS ALTERED. THE IMPROVEMENT PERMIT IS VALID FOR EITHER 60 MONTHS OR WITHOUT EXPIRATION DEPENDING UPON DOCUMENTATION SUBMITTED. APPLICATION WITH SITE PLAN 60 MONTHS, APPLICATION WITH COMPLETE, SCALED PLAT WITHOUT EXPIRATION. SEE 15A NCAC 18A .1937(f) FOR DETAILS.

Page 2: *Site Plan Worksheet* form MUST accompany this application

The following optional attachments may also be submitted: ( ) Survey Plat, scaled no more than 1 inch = 60 feet
Place an (X) beside whichever is submitted if applicable (X) Custom Site Plan, scaled no more than 1 inch = 60 feet

Applicant Information: (PRINT CLEARLY)

Applicant Name: PETER SARITO Address: P.O. Box 81435 Port St. Lucie FL Zip: 34982
Applicant Email: PMSPRITO14@GMAIL.COM Phone: 516-758-1729 Alt. Phone:
Owner Name: SAME Address: Zip:
Owner Email: Phone: Alt. Phone:

Call Paul Perkins w/ questions & when permit ready

Property Information:

Street Address: 150 E. MORRISON CREEK Rd.
Subdivision Name: DEERCROFT Section/Phase: III Lot Number: 144
Driving Directions: 115 N, L Scotts Creek, L Miller Farm Rd. ANTER L RED BARN L, EAST MORRISON

Site Development Information: *(check or complete ALL that apply* CREEKS **CHECK FOUNDATION TYPE**

(X) New Single Family Residence Maximum Number of Bedrooms: 3 (X) Crawl Space Foundation (SARITO)
( ) New Multi-Family Residence Maximum Number of Occupants: 6 (X) Concrete Slab Foundation
( ) Accessory Building ( ) Swimming Pool ( ) Basement with Plumbing
( ) Bedroom(s) Addition ( ) Other Addition/Structure: ( ) Basement without Plumbing
( ) Repair to failing septic system ___ Tank ___ Drain lines Describe Problem:
Non-Residential Site Development: Type of Business:
Square Footage of Building: Max. Number of Employees: Max. Number of Seats/Beds/Other:

Water Supply: ( ) Replacement Well – Reason:
( ) Multi-connection Well Number of Houses: Number of Persons:
( ) New Well ( ) Existing Well ( ) Community Well (X) City Water ( ) Other Public Water

Desired Septic System Type: *(you may rank in order of preference)* Year existing system installed:
( ) No Preference ( ) Alternative ( ) Conventional ( ) Innovative ( ) Modified Conventional (X) Other: 2-1

Please answer the following to the best of your ability:
( ) Yes ( ) No Does the site contain any jurisdictional wetlands? (SARITO)
( ) Yes (X) No Is any non-domestic sewage (i.e. industrial) to be generated?
( ) Yes (X) No Is the site subject to approval by any other public agency?

I have read this application and certify that the information provided herein is true, complete, and correct. Authorized county and state officials are granted right of entry to conduct necessary inspections to determine compliance with applicable laws and rules. I understand that I am solely responsible for the proper identification and labeling of all property lines and corners and making the site accessible so that a complete site evaluation can be performed.

Signature: _____ 4-2-18
Property owner or owner's legal representative signature (SIGNATURE REQUIRED) DATE

IREDELL COUNTY DEPARTMENT OF ENVIRONMENTAL HEALTH

DOCUMENTATION TO AUTHORIZE AN OWNER'S LEGAL REPRESENTATIVE

(Check and sign only ONE of the options below)

☐ **1. * APPLICANT AND OWNER ARE THE SAME. *** (*Sign here*) Peter Spirito

Applications for permits require the "signature of the owner or owner's legal representative" (15A NCAC 18A .1937). If the owner does not sign the application himself or herself, they can submit any one of the following documents to designate their legal representative: *Power of Attorney; Real Estate Contract; Estate executor; Bankruptcy trustee; Court ordered guardianship*

In the absence of the above documentation, the property owner may provide the local health department with documentation that designates a legal representative. A property owner may:

Complete this form to document his or her legal representative, or provide his or her own form that contains the information in this form. If there are multiple property owners, then all property owners must sign the form that designates a legal representative.

By signing a form that designates a legal representative for purposes of 15A NCAC 18A .1937, the property owner authorizes that representative to act on their behalf in matters pertaining to the application and permitting process, including signing or receiving any application, document or permit. The owner retains full responsibility to meet all permit conditions specified by the local health department.

☐ **2.** I, Peter M Spirito, am the legal owner(s) of the property located at 150 E Morrison Cir, Statesville, identified as PIN (Parcel Identification Number) 4726602090, located in Iredell County, North Carolina.

I do hereby authorize **(print legal representative/company name)** Chad Holloway, America's Home Place Inc., to act as an agent on my behalf in applying for/signing/obtaining any of the documents described below.

- Application for Improvement Permit (IP) / Authorization to Construct (AC)
- Improvement Permit (IP) / Authorization to Construct (AC)
- Application for soil-site evaluation (new/repair)
- Application/permit for private drinking water well/well abandonment
- Application for Compliance Inspection

I agree to abide by all decisions and/or conditions between the legal representative acting on my behalf and the Iredell County Department of Public Health, Environmental Health Division.

Peter Spirito — Signature of Owner(s)

7/31/18 — Date

Mooresville - Environmental Health
ronda.hart@co.iredell.nc.us
Fax: 704-662-3239
610 E. Center Avenue, Mooresville, NC 28115

Statesville - Environmental Health
adrienne.shea@co.iredell.nc.us
Fax: 704-871-3483
349 N. Center Street, Statesville, NC 28677

IREDELL COUNTY DEPARTMENT OF ENVIRONMENTAL HEALTH

DOCUMENTATION TO AUTHORIZE AN OWNER'S LEGAL REPRESENTATIVE

Applications for permits require the "signature of the owner or owner's legal representative" (15A NCAC 18A .1937). If the owner does not sign the application himself or herself, they can submit any one of the following documents to designate their legal representative:

Power of Attorney; Real Estate Contract; Estate executor; Bankruptcy trustee; Court ordered guardianship

In the absence of the above documentation, the property owner may provide the local health department with documentation that designates a legal representative. A property owner may:

Complete this form to document his or her legal representative, or provide his or her own form that contains the information in this form.

If there are multiple property owners, then all property owners must sign the form that designates a legal representative.

By signing a form that designates a legal representative for purposes of 15A NCAC 18A .1937, the property owner authorizes that representative to act on their behalf in matters pertaining to the application and permitting process, including signing or receiving any application, document or permit. The owner retains full responsibility to meet all permit conditions specified by the local health department.

I, Peter Spirito, am the legal owner(s) of the property located at 150 E. Morrison Creek Road, identified as PIN (Parcel Identification Number) 4726602090.000, located in Iredell County, North Carolina.

I do hereby authorize **(print legal representative/company name)** Paul Penninger / Lynn Barker Penninger Soil Consulting / AmericasHomePlace, to act as an agent on my behalf in applying for/signing/obtaining any of the documents described below.

- Application for Improvement Permit (IP) / Authorization to Construct (AC)
- Improvement Permit (IP) / Authorization to Construct (AC)
- Application for soil-site evaluation (new/repair)
- Application/permit for private drinking water well/well abandonment
- Application for Compliance Inspection

I agree to abide by all decisions and/or conditions between the legal representative acting on my behalf and the Iredell County Department of Public Health, Environmental Health Division.

4.2.18 — Signature of Owner(s) — Date

4/2/18 — Signature of Witness — Date

ANDREW BROWN Notary Public, State of Florida Commission# GG 38120 My comm. expires April 28, 2021

Please return this signed form to the appropriate office:

Mooresville - Environmental Health
ronda.hart@co.iredell.nc.us
Fax: 704-662-3239
610 E. Center Avenue, Mooresville, NC 28115

Statesville - Environmental Health
adrienne.shea@co.iredell.nc.us
Fax: 704-871-3483
349 N. Center Street, Statesville, NC 28677


IREDELL COUNTY DEPARTMENT of ENVIRONMENTAL HEALTH

SITE PLAN WORKSHEET

SEE THE "SAMPLE SITE PLAN" BELOW. *INCOMPLETE SITE PLANS WILL BE RETURNED TO YOU FOR COMPLETION AND MAY RESULT IN A DELAY IN THE ISSUANCE OF YOUR SEPTIC SYSTEM OR WELL PERMIT!!!*

Place an (X) beside each item as you complete the site plan:

- (X) Property Line measurements are clearly identified
- (X) All proposed structures are indicated
- (X) Front and side setbacks from property line
- (X) Preferred driveway location
- ( ) Preferred well location N/A
- (X) Preferred septic system location
- (X) North arrow, or other sufficient indicator of direction

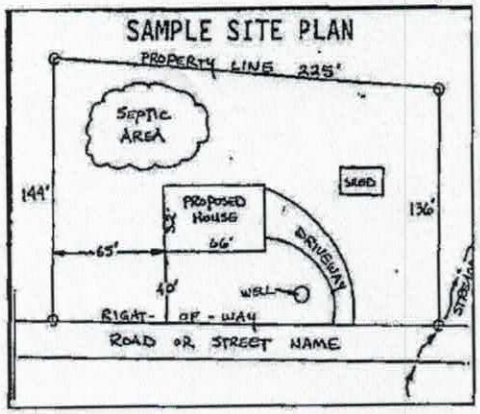

Circle N/A on the following if appropriate:

Location of septic systems and wells within 100' of your property	N/A
Location of easements and rights of ways on your property	N/A
Location of any designated wetlands on the property	N/A


USE THIS SPACE TO DRAW YOUR SITE PLAN


Show: proposed house or business footprint, wells, water lines, patios, pools and decks, and any other item that will occupy space on the site

SEE ATTACHED

Signature: _____ 4-2-18

Property owner or owner's legal representative signature (SIGNATURE REQUIRED) **DATE**

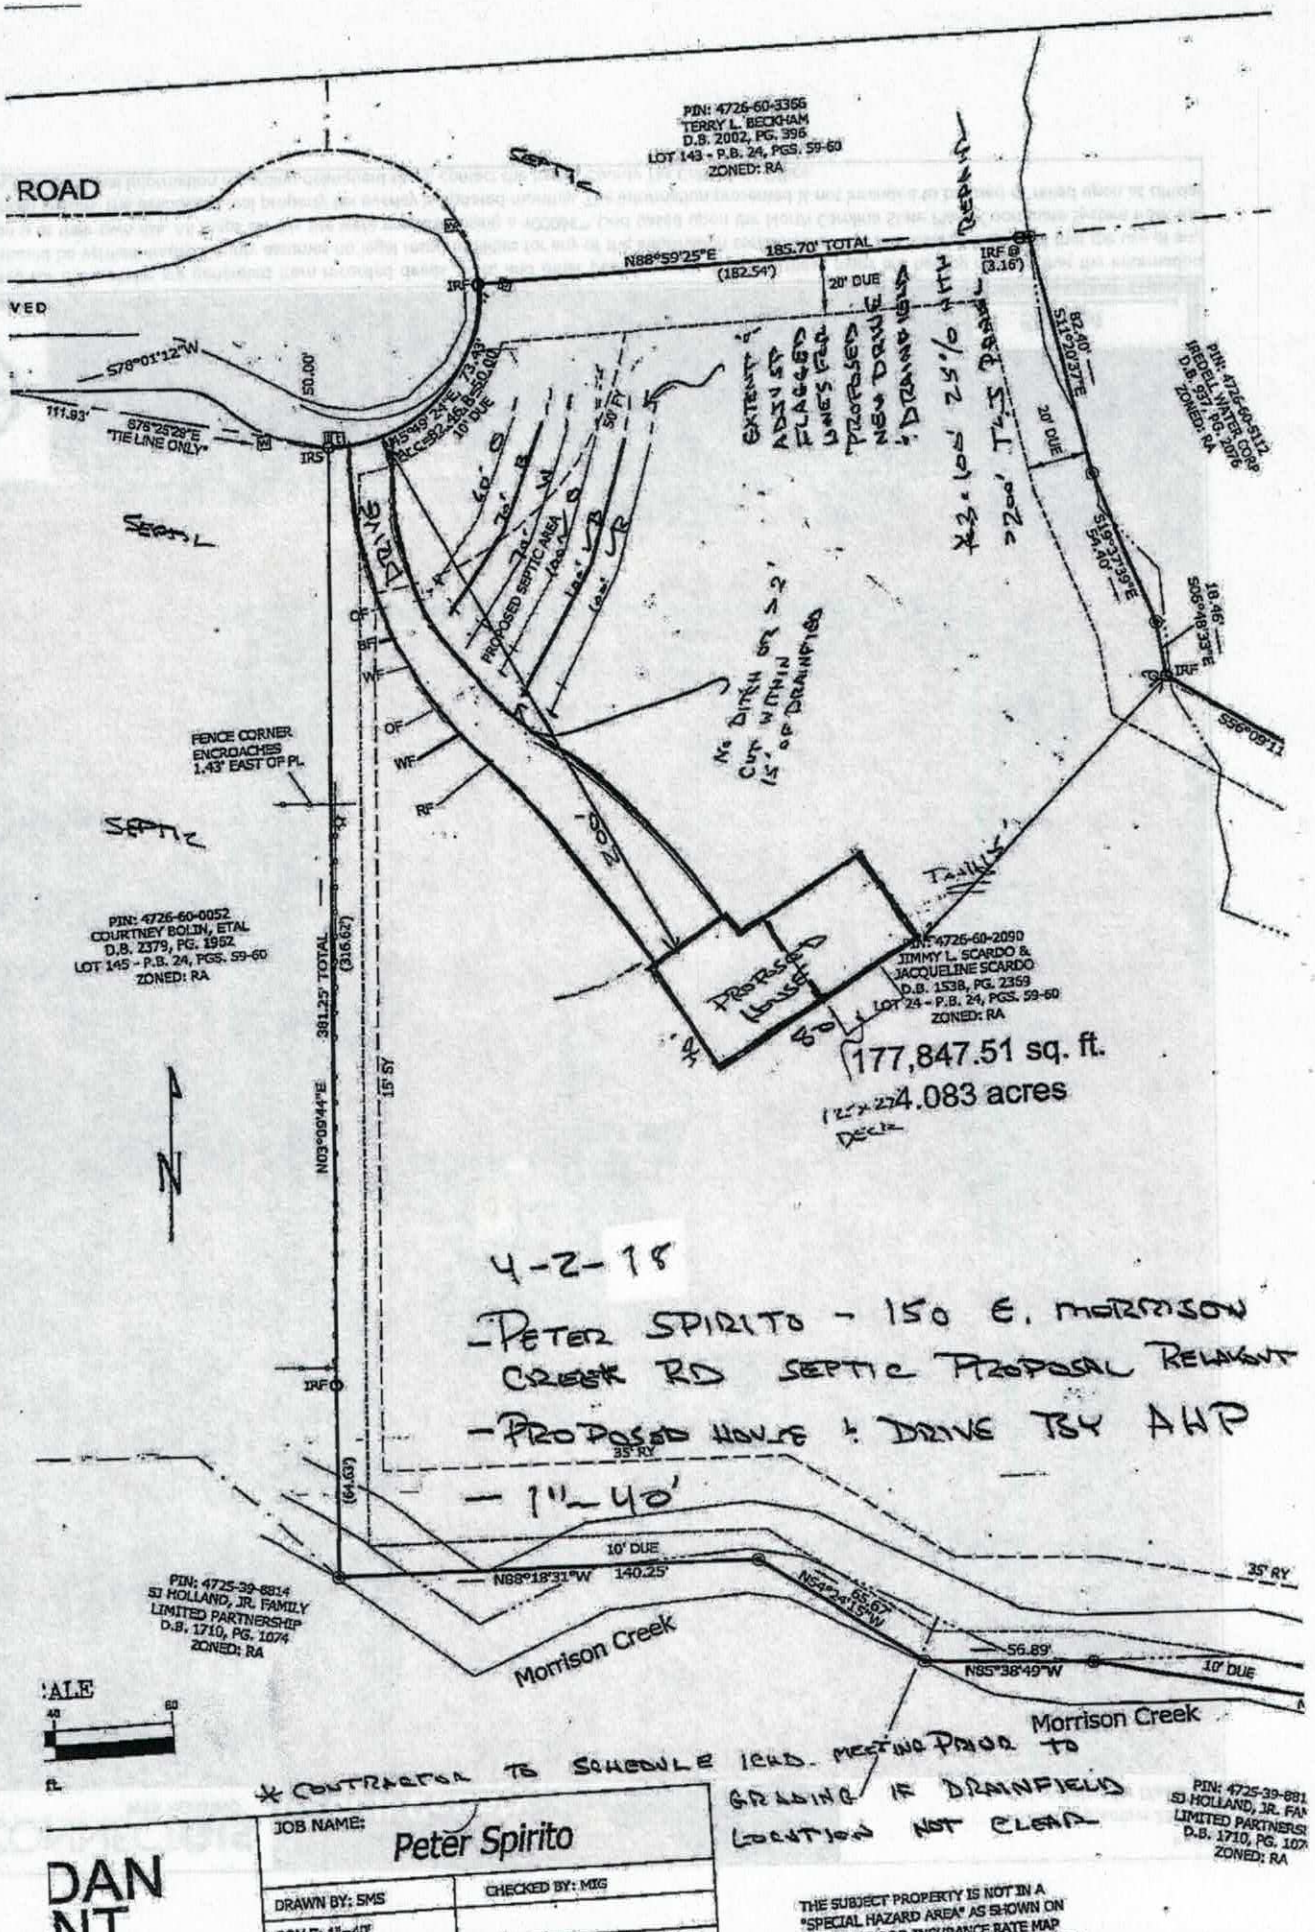
PIN: 4726-60-3366
TERRY L. BECKHAM
D.B. 2002, PG. 396
LOT 143 - P.B. 24, PGS. 59-60
ZONED: RA
ROAD
N88°59'25"E 185.70' TOTAL
(182.54')
20' DUE
IRF @ (3.16')
S78°01'12"W
50.00'
111.93'
S78°25'28"E
"TIE LINE ONLY"
IRS
S15°49'24"E 73.43'
ARC=82.46 R=50.00
10' DUE
PROPOSED SEPTIC AREA
EXTENT OF ADVISE FLAGGED LINES FOR PROPOSED NEW DRIVE & DRAINFIELD
S23°10'25"W 24.10'
>200' TO PERM. STREAM
S11°10'37"E 82.40'
20' DUE
S19°37'39"E 54.20'
PIN: 4726-60-5112
MIDDELL WATER CORP
D.B. 557, PG. 2076
ZONED: RA
S06°49'33"E 18.46'
IRF
S56°09'11"
FENCE CORNER ENCROACHES 1.43' EAST OF PL.
PIN: 4726-60-0052
COURTNEY BOLIN, ETAL
D.B. 2379, PG. 1952
LOT 145 - P.B. 24, PGS. 59-60
ZONED: RA
N03°09'44"E 381.25' TOTAL (316.92')
15' SY
IRF
(64.63')
PIN: 4726-60-2090
JIMMY L. SCARDO & JACQUELINE SCARDO
D.B. 1538, PG. 2359
LOT 24 - P.B. 24, PGS. 59-60
ZONED: RA
PROPOSED HOUSE
177,847.51 sq. ft.
4.083 acres
35' RY
10' DUE
N88°18'31"W 140.25'
N54°24'15"W 65.67'
56.89'
N85°38'49"W
10' DUE
PIN: 4725-39-8814
SJ HOLLAND, JR. FAMILY LIMITED PARTNERSHIP
D.B. 1710, PG. 1074
ZONED: RA
Morrison Creek
Morrison Creek
SCALE
4-2-18
-PETER SPIRITO - 150 E. MORRISON CREEK RD SEPTIC PROPOSAL RELAVANT
-PROPOSED HOUSE & DRIVE TBY AHP
- 1"=40'
* CONTRACTOR TO SCHEDULE ICRD. MEETING PRIOR TO GRADING IF DRAINFIELD LOCATION NOT CLEAR
JOB NAME: Peter Spirito
DRAWN BY: SMS
CHECKED BY: MIG
SCALE: 1"=40'
PIN NO: 4726-60-2090
THE SUBJECT PROPERTY IS NOT IN A "SPECIAL HAZARD AREA" AS SHOWN ON HUD/FIA FLOOD INSURANCE RATE MAP
PIN: 4725-39-881
SJ HOLLAND, JR. FA
LIMITED PARTNERSH
D.B. 1710, PG. 107
ZONED: RA

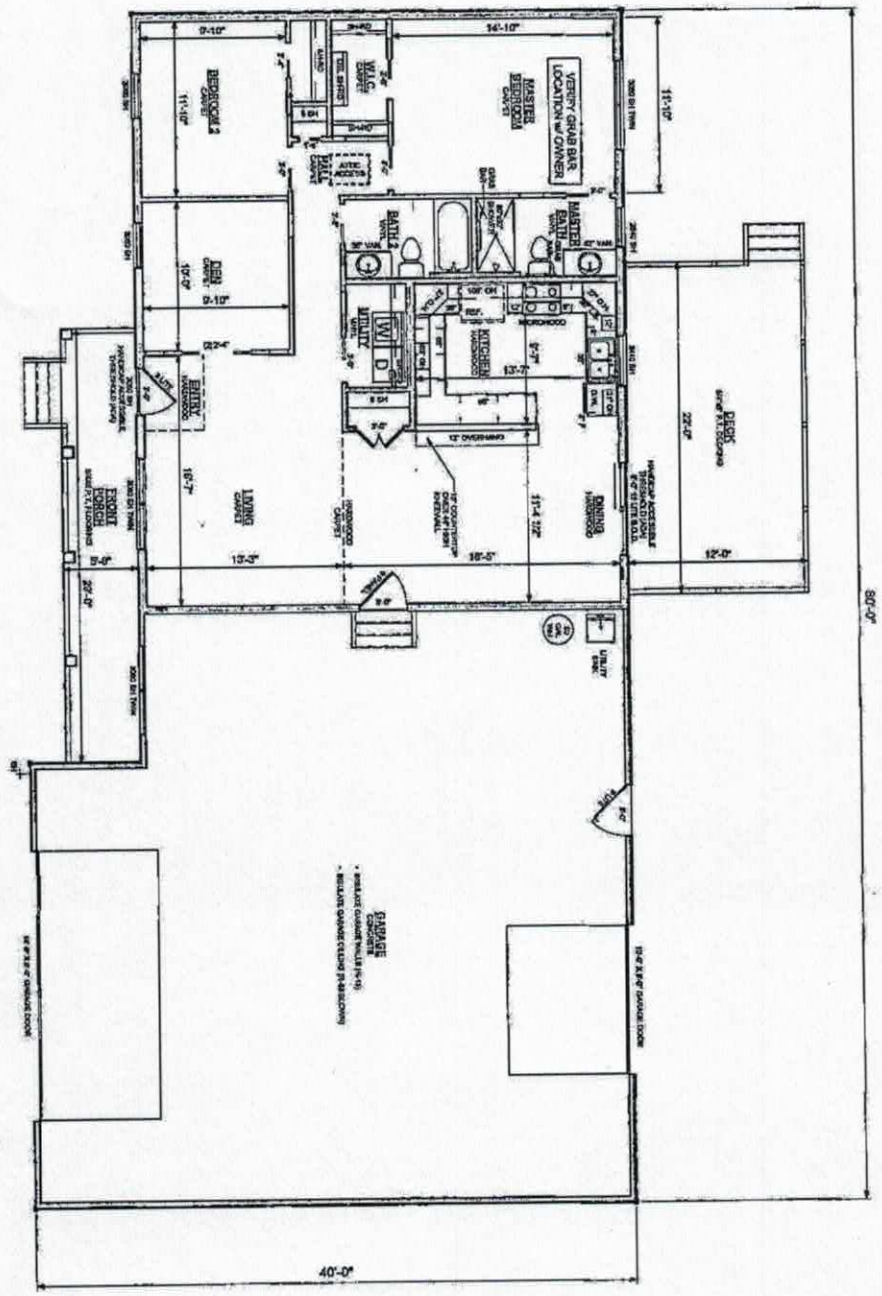

SPECIAL NOTES

- LAMINATE KITCHEN COUNTERTOPS W/ 4" GRANITE BACKSPLASH AND UNDERMOUNT SINK
- CULTURED MARBLE BATHROOM VANITY TOPS WITH UNDERMOUNT SINKS IN ALL BATHS
- BATH FAUCETS TO BE SINGLE LEVER, DELTA 82XMPUDST-CPHROME
- SMOOTH CEILINGS ON FIRST FLOOR THROUGHOUT
- HANDICAP ACCESSIBLE THRESHOLD FOR (2) ENTRY DOORS
- ARGON GAS FILLED GLASS FOR ALL WINDOWS AND EXTERIOR DOORS
- TOP SWITCHED OUTLETS IN (3)BEDROOMS, LIVING ROOM, DEN, DINING & HALL
- BIO MIRRORS
- NO HARDWARE ON CABINETS
- 6'-0" SLIDING GLASS SHOWER DOOR IN MASTER SHOWER (SILVER TONE)
- INSULATE GARAGE WALLS (R-15)
- INSULATE GARAGE CEILING (R-38 BLOWN)

PRELIMINARY DESIGN PLANS

TO REPORT COPYRIGHT VIOLATIONS CALL (770)532-1128 THE USE OF THIS PLAN BY ANYONE OTHER THAN AN AGENT OF "AMERICA'S HOME PLACE, INC." IS IN VIOLATION OF THE FEDERAL COPYRIGHT VIOLATION ACT. $100 REWARD FOR RECOVERING AN ACTUAL COPYRIGHT INFRINGEMENT.

PAGE: DP-3	PROPERTY OF:	REVIEWED BY: W. BAXLEY	JOB#: 87-17-075	FORD B	PLAN AREAS:
		REVISED BY:	2x6 EXTERIOR WALLS UNLESS OTHERWISE NOTED	FOR: PETER SPIRITO	FIRST FLOOR HEATED 1307 S.F. COVERED PORCH 145 S.F. GARAGE 1528 S.F. TOTAL UNDER ROOF 2980 S.F. DECK 264 S.F.
2/23/2018 5:48:30 PM	© COPYRIGHT - 2018		FOUNDATION TYPE: CRAWL	144 MORRISON CREEK RD, STATESVILLE, NC 28625	
FLOOR PLAN	DRAFTER: T. RAWL, J. VALLES	SOLD BY: J. SCHOOLEY	OFFICE: STATESVILLE, NC		

Revision Schedule		
Revision Number	Revision Description	Revision Date

IREDELL COUNTY

PO Box 788
349 North Center St.
Statesville, NC 28677

APPLICATION NUMBER
232185
Issue Date: 12/15/2017

ZONING PERMIT

Open Space

Parcel Number	Street Address	Jurisdiction
4726602090.000	150 EAST MORRISON CREEK ROAD, STATESVILLE, NC 28625	

Owner Information	Applicant Information
Owner: SCARDO JIMMY LEE+JACQUELINE	Applicant: SPIRITO, PETER M.
Address: 145 IREDELL CO, NC 28625	Address: 6456 NW HALIBUT ST FORT PIERCE, FL 34986
Phone:	Phone: 561-758-1291

Use Requested	Zone Code

Lot Acreage	F Setback	B Setback	L Setback	R Setback	Watershed	Flood Zone
4.080	35.00	35.00	15.00	15.00	NO	X

Remarks:

Lots with a perennial stream: must meet both the 50-foot setback from the streambank and the 35-foot setback from the rear property line for any structure.

The applicant certifies that there are no deed restrictions, contractual agreements or governmental regulations of any kind that interfere with or prohibit the use of the property or the use for which this permit is requested. The applicant further acknowledges that enforcement of deed restrictions, plat conditions and other contractual agreements will not be undertaken by Iredell County and is the sole responsibility of the affected parties.


Applicant: _____ Date: _____

Permit Number	123605	TOTAL FEES:	$ 77.25

232185

124039

ZONING DISCLAIMER

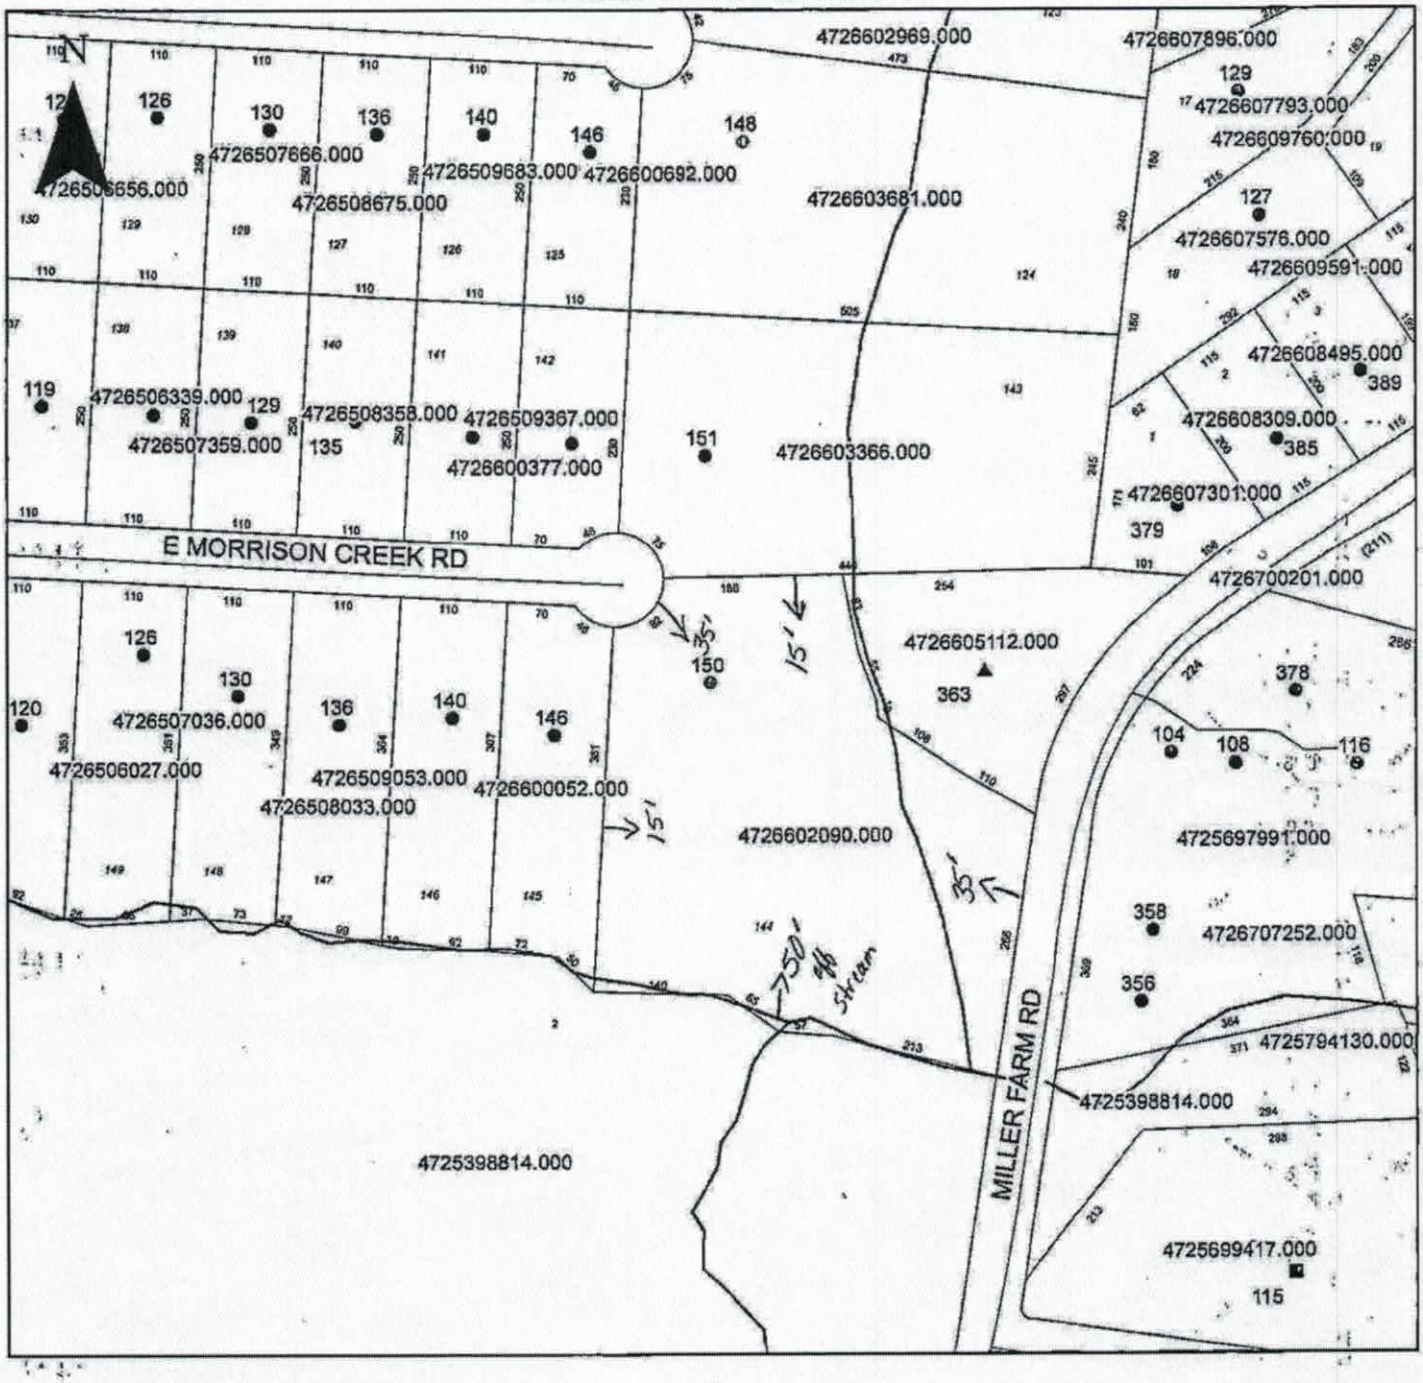

Property Address 150 E. Morrison Creek Rd.

The applicant certifies that there are no deed restrictions, contractual agreements or governmental regulations of any kind that interfere with or prohibit the use of the property or the use for which this permit is requested. Applicant further acknowledges that the enforcement of deed restrictions, plat conditions, and other contractual agreements will not be undertaken by Iredell County and is the sole responsibility of the affected parties.

Applicant

12-15-17

Date