IREDELL COUNTY HEALTH DEPARTMENT

THIS PERMIT VOIDS PREVIOUS ISSUED 8/29/94

STATESVILLE 704-878-5305 MOORESVILLE 704-664-5281

IMPROVEMENT PERMIT / AUTHORIZATION TO CONSTRUCT / OPERATION PERMIT / EXISTING SYSTEM INSPECTION

PERMIT# 19231 (98293 PIN# 9A-9-A-143 DATE 3-26-98

OWNER OR CONTRACTOR RODDEY N. GIBSON PHONE: Business Home 878-6427

ADDRESS 217 N. BOST ST, STATESVILLE, NC 28677

LOCATION NC 115 N, TL SCOTTS CREEK, TL MILLER FARM, TR ANTLER, TL REDBUCK, TL MORRISON CREEK, 6MI ON (6)

SUBDIVISION DEERCROFT BLOCK / SECTION III LOT 143 LOT AREA 2.9414 SITE CLASS. PS DESIGN FLOW 360 L.T.A.R. 0.25 GPD/FT²

Septic Tank: 1000 Gallons; STB 620 Date 11-17-98

Pump Tank: Gallons; PT Date

Pump Make: Model Serial No.

Nitrification Field: No Fields 1 Square Feet 1440 Linear Feet 480

Nc Lines SIX Trench Width 36" Max Trench Bottom Depth 36" Gravel Depth 12"

☑ New System ☐ Repair System Type: I, II, III, IV, V, VI

System Description: CONVENTIONAL GRAVITY

Repair System Description: PTBRS GRAVITY

Maintenance Agreement Required: ☐ Yes ☑ No

☑ House/Mod. Home No. Bedrooms 3

☐ Mobile Home No. Bathrooms 2½

☐ Business No. Employees

☐ Other


☐ Slab ☐ Crawl Space ☑ Basement w/plumbing ☐ Basement wo/plumbing

Water Supply: ☐ Individual ☑ Public ☐ Community

Comments:/Conditions: USE ONE FLOW DIVIDER TEE TO ACHIEVE EQUAL DISTRIBUTION INTO TWO SERIES OF DROP BOXES OF THREE LINES EACH.

Comments:/Conditions:

INITIAL SITE SKETCH SCALE: 1"=60'

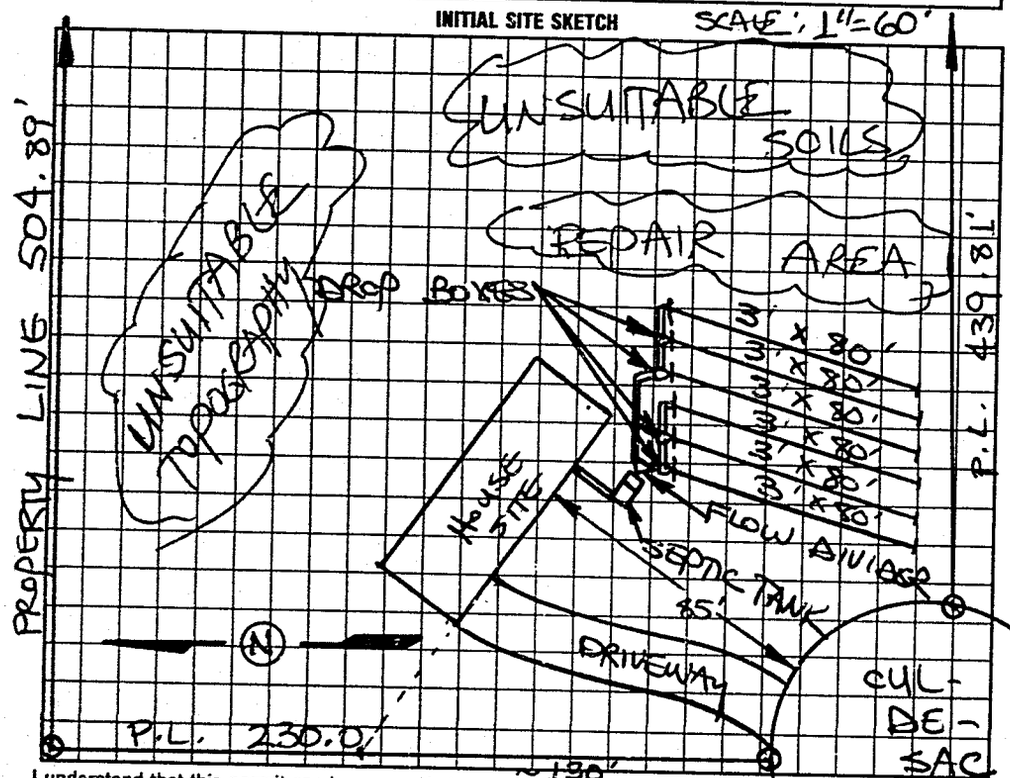

AS BUILT SKETCH

Installed as shown

I understand that this permit can be suspended or revoked if any false information is supplied toward securing the permit/any unauthorized changes are made to the site/any unauthorized changes are made in the installation of the system. Improvement Permit with plat valid without expiration. Improvement Permit with site plan valid for sixty months. Authorization to Construct is valid for a period equal to that of Improvement Permit – not to exceed sixty months.

Signed: Michelle T Daughtry date 4/8/98

Improvement Permit by: STEVE HEDRICK date 3-26-98

Authorization to Construct by: STEVE HEDRICK date 3-26-98

Installed by: James Hudder

Operation Permit by: Mark Coffey date 5-18-98

Existing System Inspection by: date

HEALTH DEPT. COPY: WHITE INSPECTION COPY (FINAL): GREEN OWNER COPY (FINAL): YELLOW INSPECTION COPY (INITIAL): PINK OWNER COPY (INITIAL): GOLD