IREDELL COUNTY HEALTH DEPARTMENT

STATESVILLE 704-878-5305 MOORESVILLE 704-664-5281

IMPROVEMENT PERMIT / AUTHORIZATION TO CONSTRUCT / OPERATION PERMIT / EXISTING SYSTEM INSPECTION

PERMIT# 105717 PIN# 4726-60-7301 DATE 4-29-02

OWNER OR CONTRACTOR DAVID M. PERRY PHONE Business Home 704-838-6907

ADDRESS 332 YORK SPANN RD, STATESVILLE, NC 27020

LOCATION NC 115 N, TL SCOTTS CREEK RD, TL MILLER FARM ROAD, LOT ON RIGHT BEFORE MORRISON CREEK

SUBDIVISION FAWNWOOD BLOCK / SECTION I LOT 1 LOT AREA 0.584 ACRE SITE CLASS PS DESIGN FLOW 360 L.T.A.R. 0.30 GAD/FT²

Septic Tank: 1000 Gallons: STB 1012 Date 4-1-02

Pump Tank: Gallons: PT Date

Pump Make: Model Serial No

Nitrification Field: No Fields 1 Square Feet EQ. TO 1200 Linear Feet 300+

No Lines FOUR Trench Width 36" Max Trench Bottom Depth 24" Gravel Depth N/A

✓ New System ☐ Repair System Type: I II (III) IV V VI

System Description: 25% REDUCTION, GRAVITY

Repair System Description: 50% REDUCTION, PUMP

Maintenance Agreement Required: ☐ Yes ✓ No LOW PRES

☐ House/Mod. Home ☐ Mobile Home ☐ Business ☐ Other

No. Bedrooms 3 No. Bathrooms 2 No. Employees


Water Supply: ☐ Individual ✓ Public ☐ Community

☐ Slab ✓ Crawl Space ☐ Basement w/plumbing ☐ Basement wo/plumbing

Comments/Conditions: ① STUB-OUT PLUMBING AS SHALLOW AS POSSIBLE THROUGH GARAGE ② INSTALL 25% REDUCTION SYSTEM ③ INSTALL SUBSURFACE INTERCEPT DRAINAGE DITCH AS SHOWN BEGINNING 36" ± DEEP OUT TO DAYLIGHT

Comments/Conditions: TUFF TITE FILTER & MARKER

INITIAL SITE SKETCH

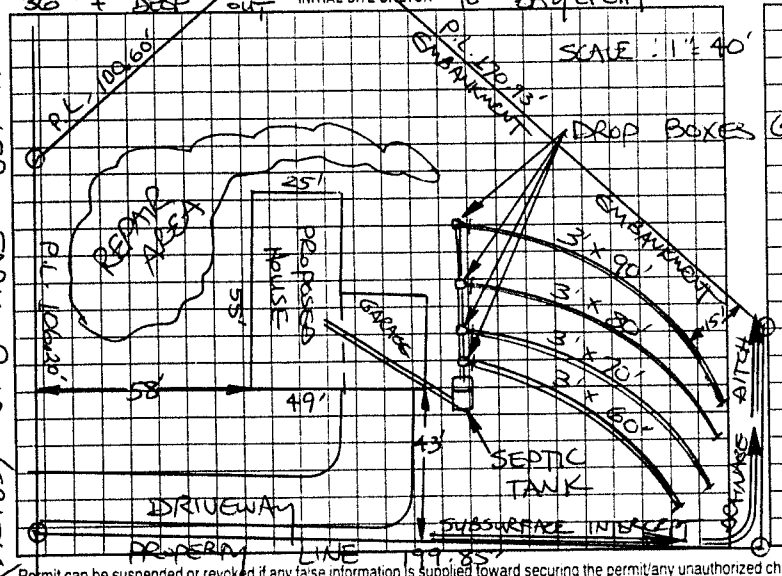

AS BUILT SKETCH

INSTALLED AS SHOWN

MILLER FARM ROAD (SR1544)

Permit can be suspended or revoked if any false information is supplied toward securing the permit/any unauthorized changes are made to the site/any unauthorized changes are made in the installation of the system. Improvement Permit with plat valid without expiration. Improvement Permit with site plan valid for sixty months. Authorization to Construct is valid for a period equal to that of Improvement Permit – not to exceed sixty months.

Signed: David M. Perry date 4-30-02 Installed by: TOMMY FRYE

Improvement Permit by: STEVE HEDRICK date 4-29-02 Operation Permit by: [signature] date 10-10-02

Authorization to Construct by: STEVE HEDRICK date 4-29-02 Existing System Inspection by: date

HEALTH DEPT. COPY: WHITE OWNER COPY (FINAL): YELLOW OWNER COPY (INITIAL): PINK