IREDELL COUNTY HEALTH DEPARTMENT

STATESVILLE 704-878-5305 MOORESVILLE 704-664-5281

IMPROVEMENT PERMIT / AUTHORIZATION TO CONSTRUCT / OPERATION PERMIT / EXISTING SYSTEM INSPECTION

PERMIT# 11155 PIN# 4726-60-7576 DATE 3/17/03

OWNER OR CONTRACTOR David Perry PHONE: Business (704) 838-6907 Home

ADDRESS 332 York-Conn Rd Harmonville NC 28020

LOCATION Hwy 115 N, @ Eotts Creek Rd, @ Miller Farm (R) Fawnwood Dr at end of Circle on left

SUBDIVISION Fawnwood BLOCK / SECTION 2 LOT 18 LOT AREA .958 Ac. SITE CLASS. B DESIGN FLOW 360 L.T.A.R. .30

Septic Tank: 1000 Gallons; STB 1012 Date 3-14-03

Pump Tank: Gallons; PT Date

Pump Make: Model Serial No.

Nitrification Field: No Fields 1 Square Feet 1200 Linear Feet 400

No Lines 4 Trench Width 36" Max Trench Bottom Depth 30" Gravel Depth 12"

☒ New System ☐ Repair System Type: I (II) III, IV, V, VI

System Description: Gravity Conv.

Repair System Description: Gravity Conv.

Maintenance Agreement Required: ☐ Yes ☒ No

☒ House/Mod. Home ☐ Mobile Home ☐ Business ☐ Other

No. Bedrooms 3 No. Bathrooms 2 No. Employees

☐ Slab ☒ Crawl Space ☐ Basement w/plumbing ☐ Basement wo/plumbing

Water Supply: ☐ Individual ☒ Public ☐ Community


Comments:/Conditions: O-Footfall Inter on Contour

Comments:/Conditions:


- Tuff-Tite Filter AST marker Footfall

top 80, 100, 120, 120 ft Inner Footfall

INITIAL SITE SKETCH 1" = 60'

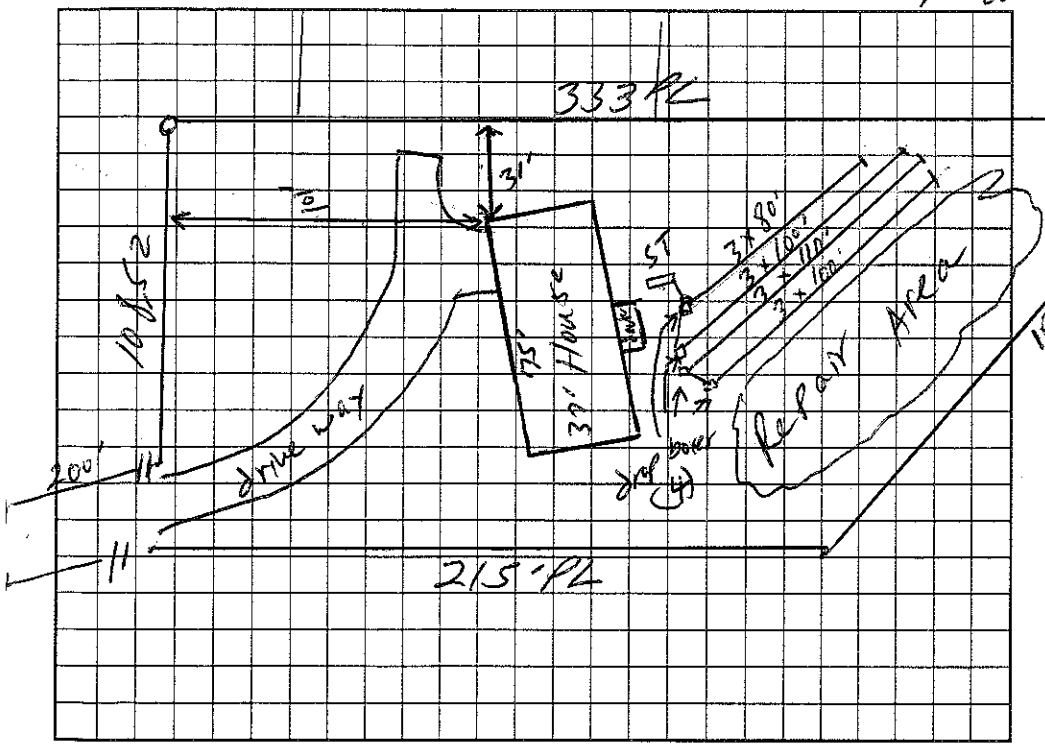

AS BUILT SKETCH

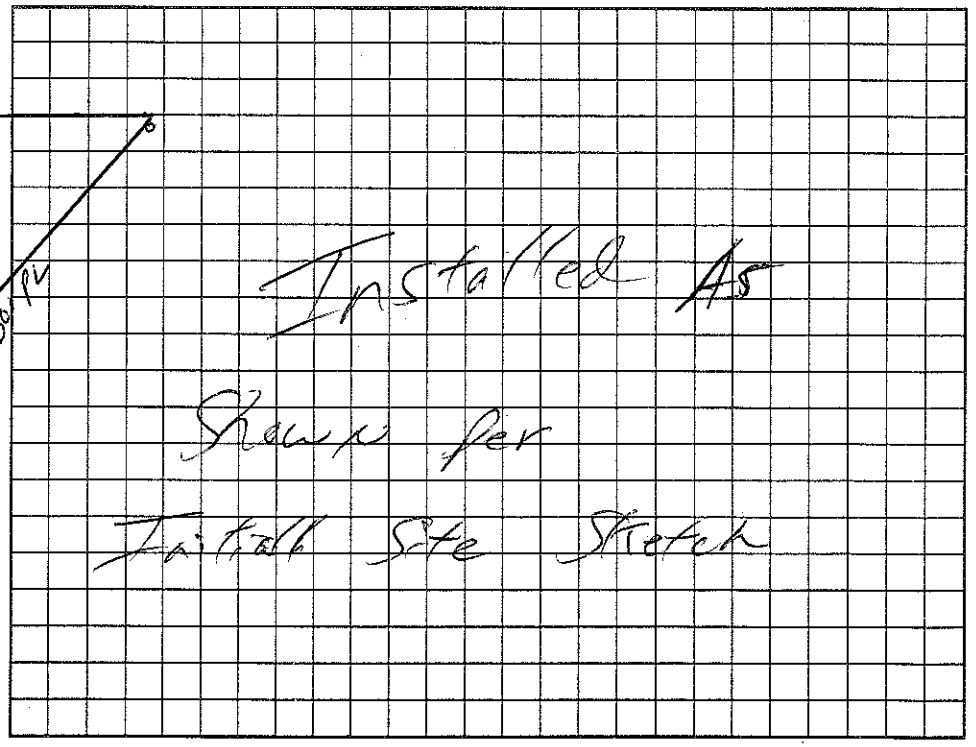

Permit can be suspended or revoked if any false information is supplied toward securing the permit/any unauthorized changes are made to the site/any unauthorized changes are made in the installation of the system. Improvement Permit with plat valid without expiration. Improvement Permit with site plan valid for sixty months. Authorization to Construct is valid for a period equal to that of Improvement Permit – not to exceed sixty months.

Signed: David M Perry date 3-18-03

Improvement Permit by: William O. Johnson date 3/17/03

Authorization to Construct by: William O. Johnson date 3/17/03

Installed by: Tommy Frye

Operation Permit by: William O. Johnson date 10-3-03

Existing System Inspection by: date

HEALTH DEPT. COPY: WHITE OWNER COPY (FINAL): YELLOW OWNER COPY (INITIAL): PINK