IREDELL COUNTY HEALTH DEPARTMENT

STATESVILLE 704-878-5305 MOORESVILLE 704-664-5281

IMPROVEMENT PERMIT / AUTHORIZATION TO CONSTRUCT / OPERATION PERMIT / EXISTING SYSTEM INSPECTION

PERMIT# 81205 PIN# 4726603309 DATE MAY 18 99

OWNER OR CONTRACTOR SONOMA Builders Inc PHONE: Business 704 376 6571 Home

ADDRESS 1505 Biltmore DR Charlotte NC

LOCATION 115 N (R) Scotts Creek (L) Miller Farm 1/4 mile on Right

SUBDIVISION FAWNWOOD BLOCK / SECTION I LOT 2 LOT AREA .53 SITE CLASS FS DESIGN FLOW 360 L.T.A.R. .63

Septic Tank: 1000 Gallons; STB 1012 Date 9-11-99

Pump Tank: Gallons; PT Date

Pump Make: Model 1440 Serial No.

Nitrification Field: No Fields 1 Square Feet 1260 Linear Feet ~~300~~ 480

No Lines 3 Trench Width 36" Max Trench Bottom Depth 36"

☑ New System ☐ Repair System Type: I, II, (III), IV, V

System Description: GRAVITY CONVENTIONAL

Repair System Description: ~~Same~~ 50% REDUCTION pump

Maintenance Agreement Required: ☐ Yes ☑ No

☑ House/Mod. Home ☐ Mobile Home ☐ Business ☐ Other

No. Bedrooms 3 No. Bathrooms 2 No. Employees


Water Supply: ☐ Individual ☑ Public ☐ Community

~~Gravel~~ Depth 6" Sand ☐ Slab ☑ Crawl Space ☐ Basement w/plumbing ☐ Basement wo/plumbing


Comments/Conditions: 50 Chambers or 30 HDS Sections
Install Lines on Contour
Chambers 96'+16 Chambers 100-17 Chambers
HDS Sections 10 AA 100 ft

Comments/Conditions ① SYSTEM ALTERED AS SHOWN BELOW WITHOUT PRIOR HEALTH DEPARTMENT APPROVAL ② SEPTIC TANK WITH RISERS AND MARKER INSTALLED USING "POLYLOK" FILTER

INITIAL SITE SKETCH

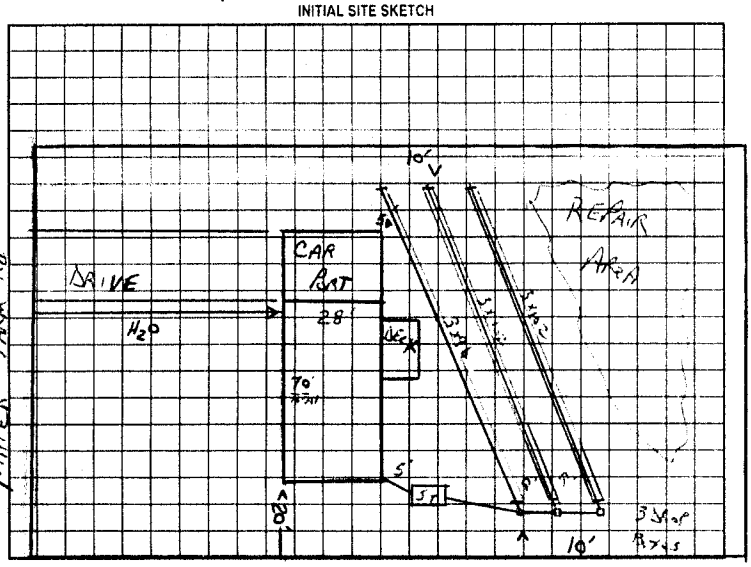

AS BUILT SKETCH

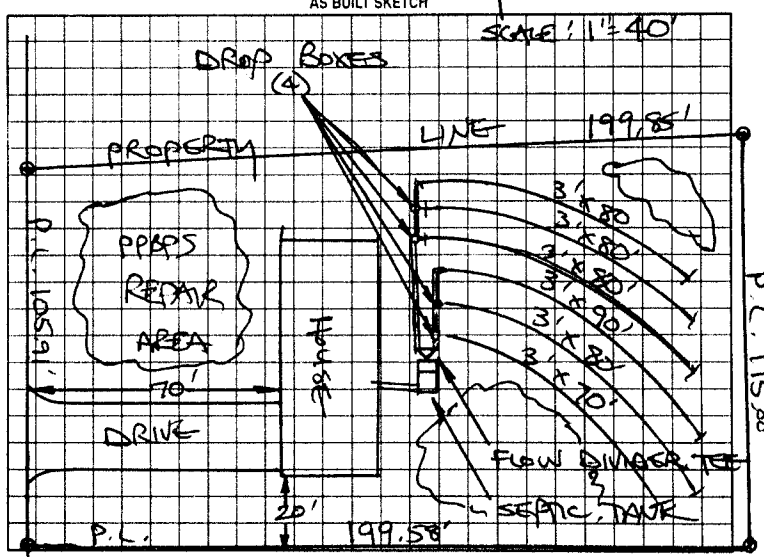

Permit can be suspended or revoked if any false information is supplied toward securing the permit/any unauthorized changes are made to the site/any unauthorized changes are made in the installation of the system. Improvement Permit with plat valid without expiration. Improvement Permit with site plan valid for sixty months. Authorization to Construct is valid for a period equal to that of Improvement Permit – not to exceed sixty months.

Signed: Todd P. Curl date

Improvement Permit by: [signature] date 5-18-99

Authorization to Construct by: [signature] date 5-18-99

Installed by: TOMMY FRYE

Operation Permit by: STEVE HENDRICK date 11-23-99

Existing System Inspection by: date

HEALTH DEPT. COPY: WHITE OWNER COPY (FINAL): YELLOW OWNER COPY (INITIAL): PINK