IREDELL COUNTY HEALTH DEPARTMENT

STATESVILLE 704-878-5305 W of I MOORESVILLE 704-664-5281

IMPROVEMENT PERMIT / AUTHORIZATION TO CONSTRUCT / OPERATION PERMIT / EXISTING SYSTEM INSPECTION

PERMIT# 094863 PIN# 4726095791 DATE 3-13-01

OWNER OR CONTRACTOR Standard Bldg. Co. Inc. PHONE: Business (704) 902-4618 Home (704) 539-4746

ADDRESS 843 Sloans Mill Road Olin NC 28660

LOCATION Hwy 115 N ① Scotts Creek Rd ② Miller Farm Rd on (R) past Fawnwood Drive

SUBDIVISION Fawn Wood BLOCK / SECTION 2 LOT 4 LOT AREA .53 Ac. SITE CLASS PS DESIGN FLOW 360 L.T.A.R. .25

Septic Tank: 4000 Gallons; STB 101 2 Date 8-5-03

Pump Tank: Gallons; PT Date

Pump Make: Model Equivalent to Serial No.

Nitrification Field: No Fields 1 Square Feet 1440 Linear Feet 360

No Lines 4 Trench Width 36" Max Trench Bottom Depth 30" Gravel Depth —

☒ New System ☐ Repair System Type: I, II, III, IV, V, VI

System Description: 25% Reduction Gravity

Repair System Description: 50% Reduction Pump

Maintenance Agreement Required: ☐ Yes ☒ No

☒ House/Mod. Home ☐ Mobile Home ☐ Business ☐ Other

No. Bedrooms 3 No. Bathrooms 2 No. Employees

☐ Slab ☒ Crawl Space ☐ Basement w/plumbing ☐ Basement wo/plumbing


Water Supply: ☐ Individual ☒ Public ☐ Community

Comments:/Conditions: ① Install 25% Reduction System using 58 HDES or Chambers ② Install on contour ③ Keep lines 10ft from property lines ④ Do not install when wet


Comments:/Conditions:

- Tuff Tite Filter + ST Marker Installed

INITIAL SITE SKETCH

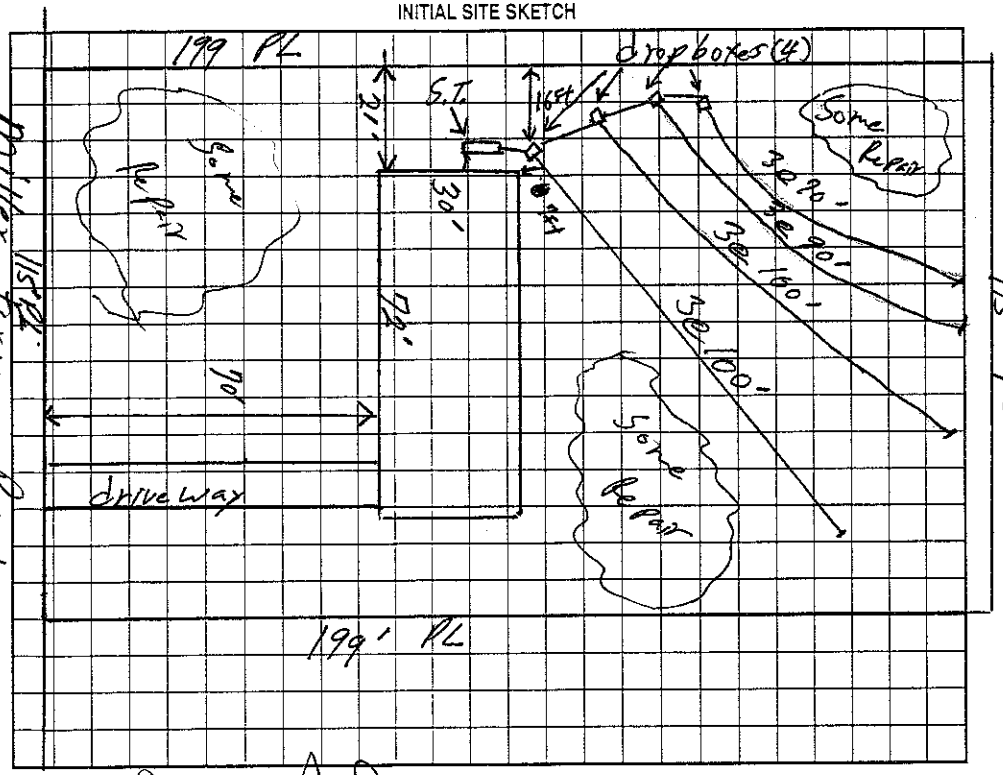

AS BUILT SKETCH

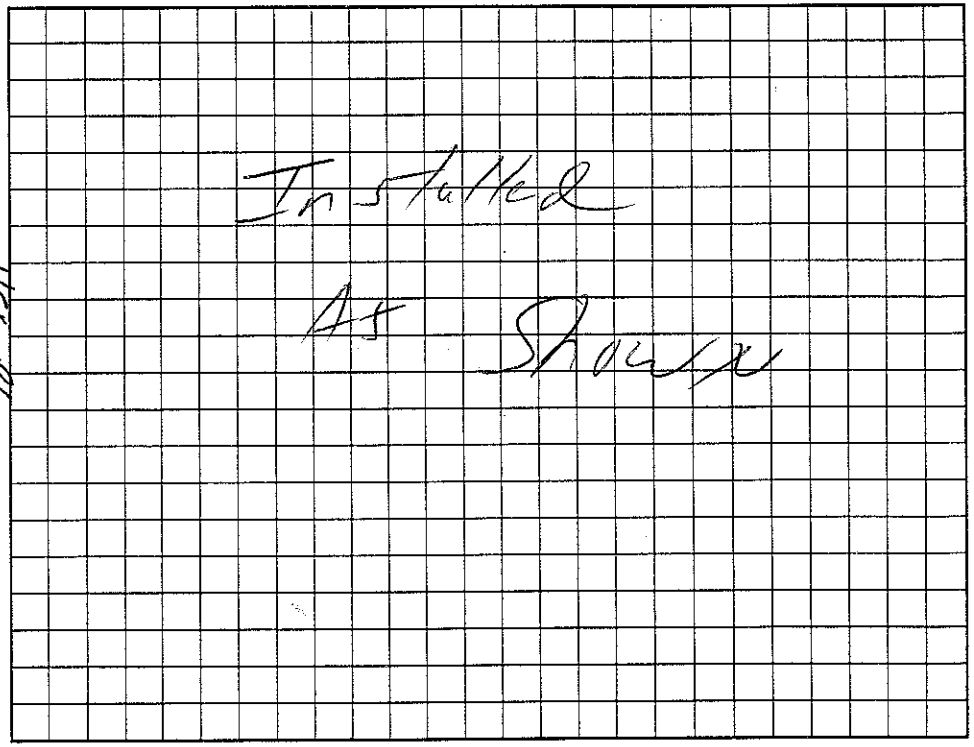

Permit can be suspended or revoked if any false information is supplied toward securing the permit/any unauthorized changes are made to the site/any unauthorized changes are made in the installation of the system. Improvement Permit with plat valid without expiration. Improvement Permit with site plan valid for sixty months. Authorization to Construct is valid for a period equal to that of Improvement Permit – not to exceed sixty months.

Signed: date 3-13-01

Improvement Permit by: William O. Johnson RSF date 3-13-01

Authorization to Construct by: William O. Johnson RSF date 3-13-01

Installed by: Steve Jordan

Operation Permit by: William O. Johnson date 1/15/04

Existing System Inspection by: date

HEALTH DEPT. COPY: WHITE OWNER COPY (FINAL): YELLOW OWNER COPY (INITIAL): PINK