IREDELL COUNTY HEALTH DEPARTMENT

STATESVILLE 704-878-5305 MOORESVILLE 704-664-5281

46902

IMPROVEMENT PERMIT / CERTIFICATE OF COMPLETION / OPERATION PERMIT / EXISTING SYSTEM INSPECTION

PROPERTY DESCRIPTION NO. 16178 DATE 6-3-93 TAX MAP NO. 9A-A-47

OWNER OR CONTRACTOR D. Matheffey PHONE: Business Home

ADDRESS

LOCATION Hwy 115 N TL Scotts Creek Rd. TL Miller Farm Rd. TR Antler Dr. at end on L

SUBDIVISION Deercroft BLOCK / SECTION LOT 47 LOT AREA 110' x 293' SITE CLASS. P.S. L.T.A.R. .35 gpd/ft²

Water Supply: ☐ Individual ☐ Community ☑ Public

Septic Tank: 1000 Gallons; STB 1012 Date 3-27-93

Pump Tank: — Gallons; PT — Date —

Nitrification Field: No Fields 1 Square Feet 1035 Linear Feet 345'

No Lines 3 Trench Width 36" Trench Depth 36" Gravel Depth 12"

☑ New System ☐ Repair System Type: I, II, IV, V, VI

System Description: Conventional, gravity

Repair System Description: " "

Maintenance Agreement Required: ☑ Yes ☐ No

☑ House/Mod. Home No. Bedrooms 3

☐ Mobile Home No. Bathrooms 2

☐ Business No. Employees —

☐ Other

☐ Slab ☑ Crawl Space ☐ Basement w/plumbing ☐ Basement wo/plumbing

Garbage Disposal: ☐ Yes ☑ No

Auto. Dishwasher: ☑ Yes ☐ No


Auto. Washing Machine: ☑ Yes ☐ No

Other

Comments 100% Repair Area below system, conventional, gravity fed.

INITIAL SITE SKETCH

AS BUILT SKETCH

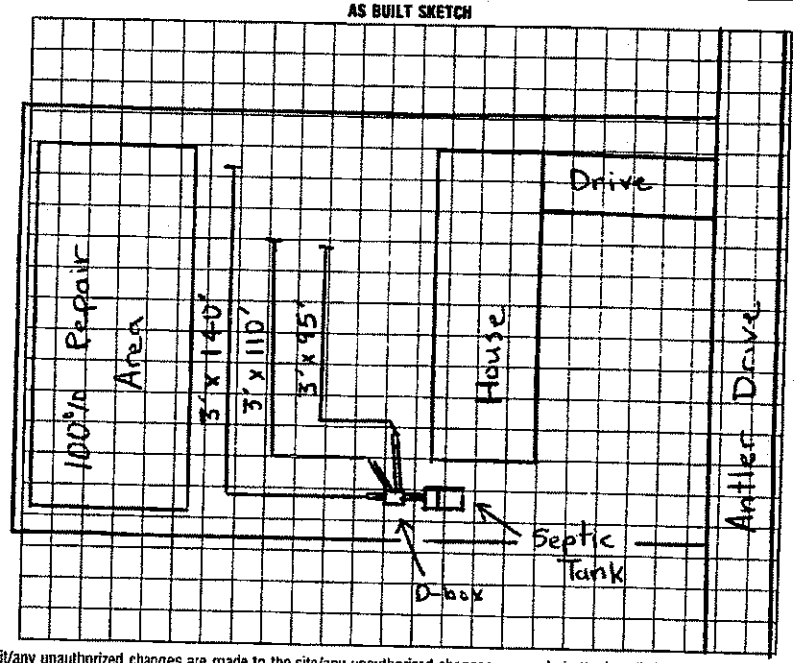

I understand that this permit can be suspended or revoked if any false information is supplied toward securing the permit/any unauthorized changes are made to the site/any unauthorized changes are made in the installation of the system. Improvement Permit is valid for 60 months from date of issuance.

Signed:

Improvement Permit by: Steve Hedrick date 4-14-93

Existing System Inspection by: date

Installed by: James Hudler

Certificate of Completion by: Michael L. Dennis date 6-3-93

Operation Permit by: date

HEALTH DEPT. COPY: WHITE INSPECTION COPY (FINAL): GREEN OWNER COPY (FINAL): YELLOW INSPECTION COPY (INITIAL): PINK OWNER COPY (INITIAL): GOLD