IREDELL COUNTY HEALTH DEPARTMENT

STATESVILLE 704-878-5305 MOORESVILLE 704-664-5281

IMPROVEMENT PERMIT / CERTIFICATE OF COMPLETION / OPERATION PERMIT / EXISTING SYSTEM INSPECTION

PROPERTY DESCRIPTION NO. 23525 DATE 4-29-96 TAX MAP NO. 9A-9-A-43 Watershed: ☐ Yes ☒ No

OWNER OR CONTRACTOR ERNEST RUNGE PHONE: Business Home 872-9502

ADDRESS 374 LONG ISLAND ROAD, STATESVILLE, NC 28677

LOCATION NC 115 N, TL SCOTTS CREEK RD, TL MILLER FARM RD, TR ANTLER DR, 0.2 MILE ON RIGHT

SUBDIVISION DEERCROFT BLOCK / SECTION I LOT 43 LOT AREA ~110X200' SITE CLASS. PS DESIGN FLOW 360 L.T.A.R. 0.33 GPD/FT2

Septic Tank: 1000 Gallons; STB 1012 Date 11-6-96

Pump Tank: ____ Gallons; PT ____ Date ____

Pump Make: ____ Model ____ Serial No. ____

Nitrification Field; No Fields 1 Square Feet 1080 Linear Feet 360

No Lines 6 Trench Width 36" Max Trench Bottom Depth 18-36" Gravel Depth 12"

☒ New System ☐ Repair System Type: I (II) III. IV. V. VI

System Description: CONVENTIONAL GRAVITY

Repair System Description: CHAMBERED GRAVITY

Maintenance Agreement Required: ☐ Yes ☒ No

☒ House/Mod. Home No. Bedrooms 3

☐ Mobile Home No. Bathrooms 2

☐ Business No. Employees ____

☐ Other ____


☐ Slab ☒ Crawl Space ☐ Basement w/plumbing ☐ Basement wo/plumbing

Water Supply: ☐ Individual ☐ Community ☒ Public


Comments:

Comments:

INITIAL SITE SKETCH

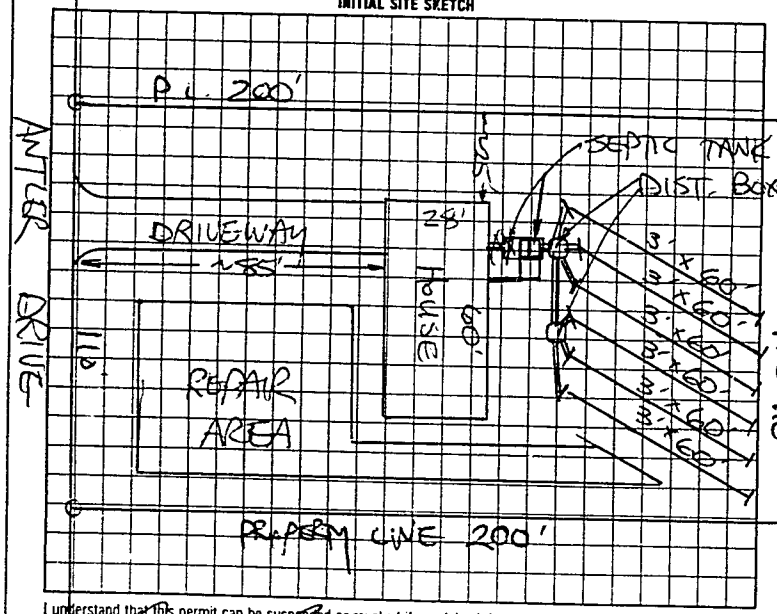

AS BUILT SKETCH

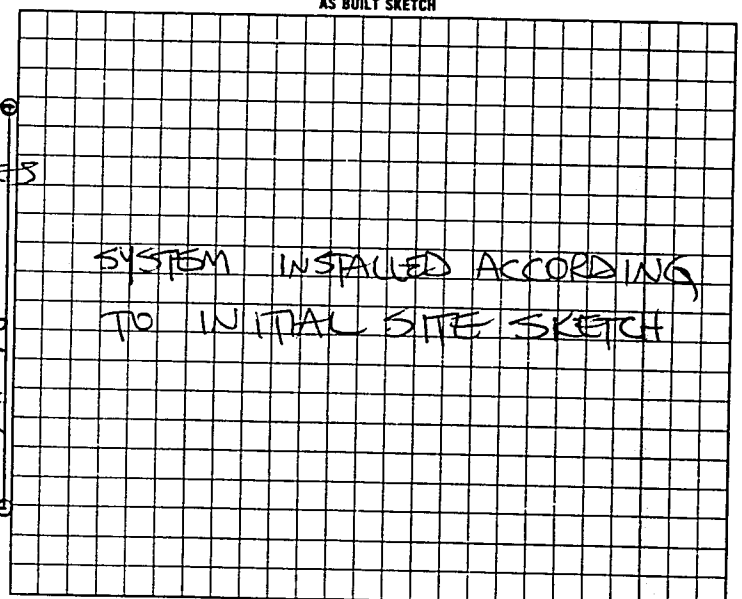

I understand that this permit can be suspended or revoked if any false information is supplied toward securing the permit/any unauthorized changes are made to the site/any unauthorized changes are made in the installation of the system.

Authorization to Construct is valid five (5) years from date of issuance. Improvement Permit has no expiration date.

Signed: [signature]

Improvement Permit by: STEVE HEDRICK date 4-29-96

Existing System Inspection by:

AUTHORIZATION TO ~~CONSTRUCT~~: STEVE HEDRICK date 4-29-96

Installed by: DALE FOX

Certificate of Completion by: ____ date ____

Operation Permit by: STEVE HEDRICK date 2-26-97

HEALTH DEPT COPY WHITE | INSPECTION COPY (FINAL) GREEN | OWNER COPY (FINAL) YELLOW | INSPECTION COPY (INITIAL) PINK | OWNER COPY (INITIAL) GOLD

0152UU