IREDELL COUNTY HEALTH DEPARTMENT

STATESVILLE 704-878-5305 MOORESVILLE 704-664-5281 50413

IMPROVEMENT PERMIT / CERTIFICATE OF COMPLETION / OPERATION PERMIT / EXISTING SYSTEM INSPECTION

PROPERTY DESCRIPTION NO. 17905 DATE 3/1/94 TAX MAP NO. 9A-9-A-19 Watershed: ☐ Yes ☑ No

OWNER OR CONTRACTOR AUSTIN & AUSTIN BUILDERS PHONE: Business Home 876-0105

ADDRESS R-9 BOX 412-B STATESVILLE, NC 28677

LOCATION NC 115 N, TL SCOTTS CREEK, TL MILLER FARM, TR DOE TRAIL, 13TH LOT ON (L)

SUBDIVISION DEERCROFT BLOCK / SECTION I LOT 19 LOT AREA 110 X 200' SITE CLASS PS DESIGN FLOW 360 L.T.A.R. 0.35 GPD/FT

Septic Tank: 1000 Gallons; STB 1012 Date 12/11/93

Pump Tank: Gallons; PT Date

Pump Make: Model Serial No.

Nitrification Field: No Fields 1 Square Feet 1035 Linear Feet 345

No Lines 4 Trench Width 36" Max Trench Bottom Depth 18-36" Gravel Depth 12"

☑ New System ☐ Repair System Type: I, (II), III, IV, V, VI

System Description: CONV. GRAVITY

Repair System Description: CONV. GRAVITY

Maintenance Agreement Required: ☐ Yes ☑ No

☑ House/Mod. Home No. Bedrooms 3

☐ Mobile Home No. Bathrooms 2

☐ Business No. Employees

☐ Other


☐ Slab ☑ Crawl Space ☐ Basement w/plumbing ☐ Basement wo/plumbing

Water Supply: ☐ Individual ☐ Community ☑ Public


Comments: (1) KEEP SYSTEM MINIMUM 5' FROM HOUSE, 10' FROM PROPERTY LINE (2) INSTALL LINES ON CONTOUR, NO DEEPER THAN 36", 9' O.C. (3) USE SERIAL DISTRIBUTION AS SHOWN.

Comments:

INITIAL SITE SKETCH

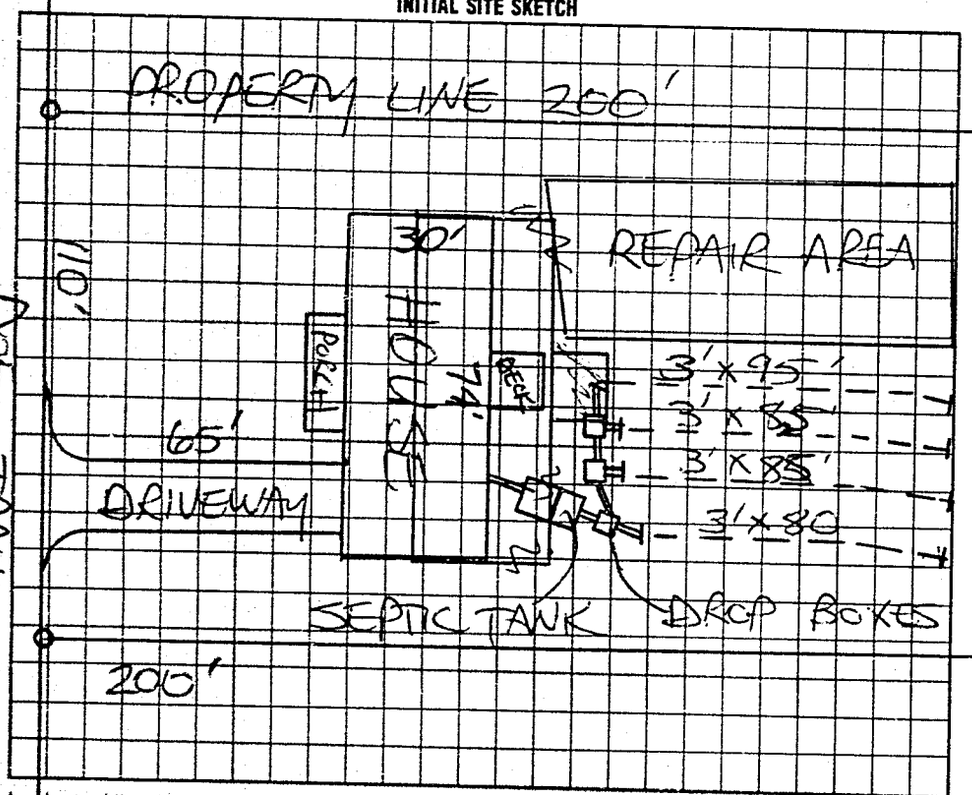

AS BUILT SKETCH

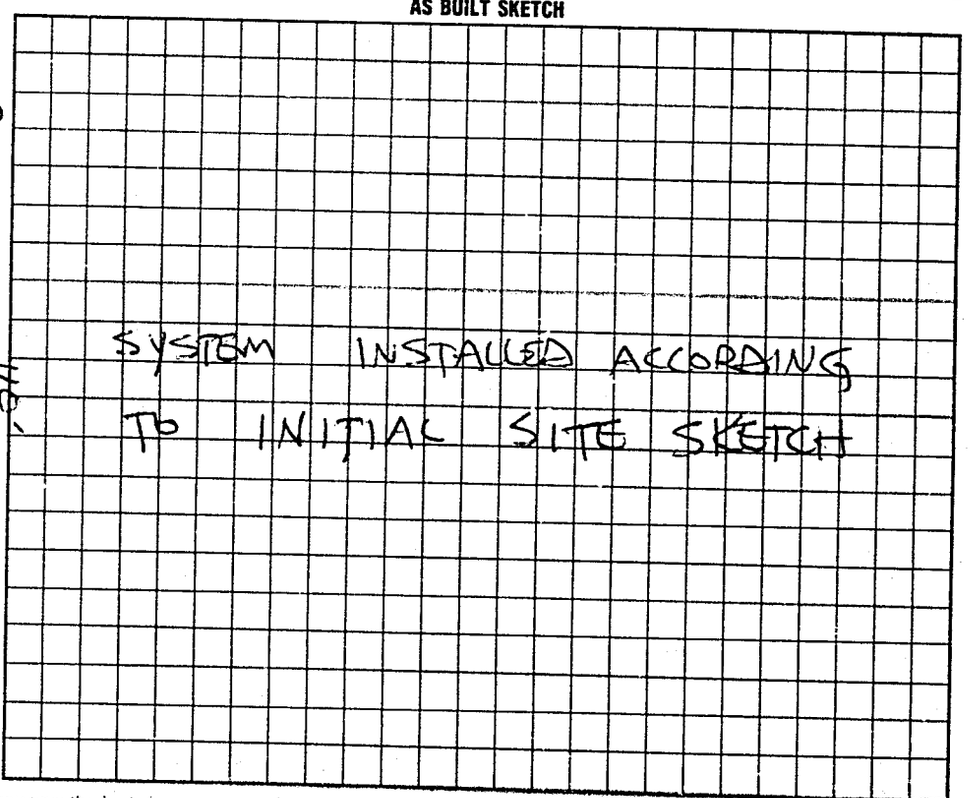

I understand that this permit can be suspended or revoked if any false information is supplied toward securing the permit/any unauthorized changes are made to the site/any unauthorized changes are made in the installation of the system. Improvement Permit is valid for 60 months from date of issuance.

Signed: Harry R. Austin

Improvement Permit by: STEVE HEDRICK date 3/1/94

Existing System Inspection by: date

Installed by: AUSTIN & AUSTIN BLDRS

Certificate of Completion by: STEVE HEDRICK date 4/28/94

Operation Permit by: date

HEALTH DEPT. COPY: WHITE INSPECTION COPY (FINAL): GREEN OWNER COPY (FINAL): YELLOW INSPECTION COPY (INITIAL): PINK OWNER COPY (INITIAL): GOLD