1880 Antler Drive 61575

IREDELL COUNTY HEALTH DEPARTMENT

STATESVILLE 704-878-5305 MOORESVILLE 704-664-5281

IMPROVEMENT PERMIT / CERTIFICATE OF COMPLETION / OPERATION PERMIT / EXISTING SYSTEM INSPECTION

PROPERTY DESCRIPTION NO. 24181 DATE 6-19-96 TAX MAP NO. 9A-9-A-42 Watershed: ☐ Yes ☑ No

OWNER OR CONTRACTOR KENNETH A. WATT PHONE: Business Home 876-0047

ADDRESS 129 BECKHAM RD STATESVILLE NC 28677

LOCATION NC 115 N, TL SCOTTS CREEK RD, TL MILLER FARM RD, TR ANTLER DR, 11TH LOT ON RIGHT

SUBDIVISION DEERCROFT BLOCK / SECTION I LOT 42 LOT AREA 110 X 200 SITE CLASS PS DESIGN FLOW 360 L.T.A.R. 0.33 GPD/FT²

Septic Tank: 1000 Gallons; STB 1012 Date 6-17-96

Pump Tank: _____ Gallons; PT _____ Date _____

Pump Make: _____ Model _____ Serial No. _____

Nitrification Field: No Fields 1 Square Feet 1080 Linear Feet 360

No Lines 6 Trench Width 36" Max Trench Bottom Depth 18-36" Gravel Depth 12"

☑ New System ☐ Repair System Type: I, II, III, IV, V, VI

System Description: CONVENTIONAL GRAVITY

Repair System Description: PRE-EXIST. GRAVITY

Maintenance Agreement Required: ☐ Yes ☑ No

☑ House/Mod. Home No. Bedrooms 3

☐ Mobile Home No. Bathrooms 2

☐ Business No. Employees _____

☐ Other _____


Water Supply: ☐ Individual ☐ Community ☑ Public

☐ Slab ☑ Crawl Space ☐ Basement w/plumbing ☐ Basement wo/plumbing


Comments: USE ONE FLOW DIVIDER TEE TO SPLIT EFFLUENT EVENLY INTO TWO DIST. BOXES FEEDING THREE LINES EACH.

Comments:

INITIAL SITE SKETCH

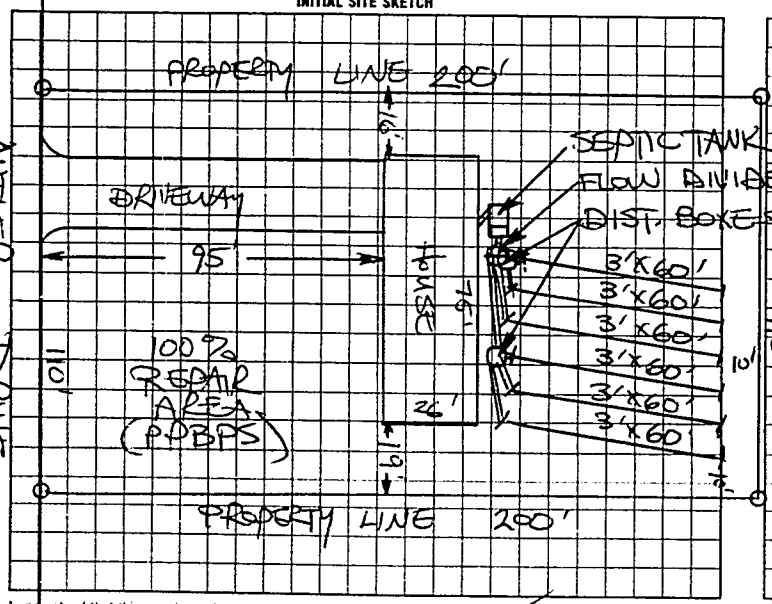

AS BUILT SKETCH

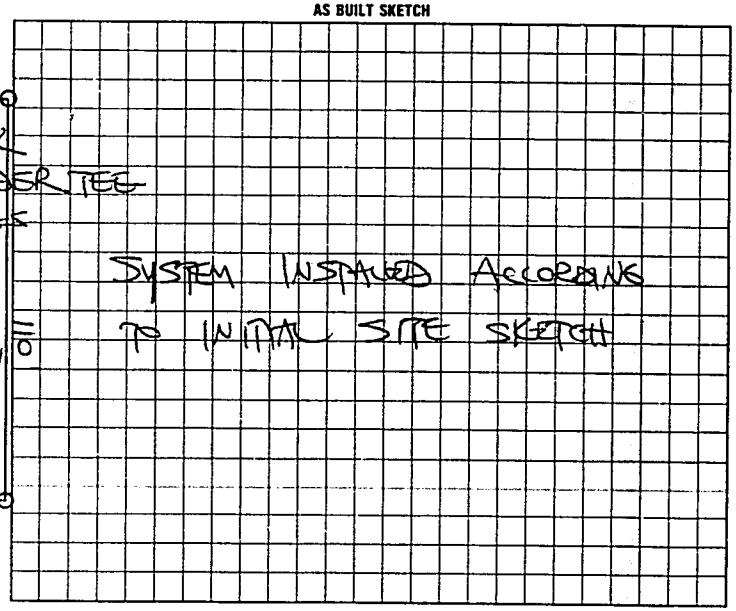

I understand that this permit can be suspended or revoked if any false information is supplied toward securing the permit/any unauthorized changes are made to the site/any unauthorized changes are made in the installation of the system. Authorization to Construct is valid five (5) years from date of issuance. Improvement Permit has no expiration date.

Signed: K Kenneth A Watt

Improvement Permit by: STEVE HENDRICK date 6-19-96

Existing System Inspection by: STEVE HENDRICK date 6-19-96

Installed by: DAVID YOUNTZ

Certificate of Completion by: _____ date _____

Operation Permit by: STEVE HENDRICK date 9-9-96

AUTHORIZATION TO CONSTRUCT: HEALTH DEPT COPY WHITE | INSPECTION COPY (FINAL) GREEN | OWNER COPY (FINAL) YELLOW | INSPECTION COPY (INITIAL) PINK | OWNER COPY (INITIAL) GOLD