IREDELL COUNTY HEALTH DEPARTMENT

STATESVILLE 704-878-5305 MOORESVILLE 704-664-5281

IMPROVEMENT PERMIT / AUTHORIZATION TO CONSTRUCT / OPERATION PERMIT / EXISTING SYSTEM INSPECTION

PERMIT# 08732 PIN# 4726 61 5537 DATE 1-21-00

OWNER OR CONTRACTOR WILLIAM ALLISON III PHONE: Business Home 873-5307

ADDRESS 2641 FINES CREEK RD STATESVILLE NC 28625

LOCATION NC 115 N, TL SCOTTS CREEK RD, TR MILLER FARM RD, TR ANTLER DR, 1ST LOT ON RIGHT

SUBDIVISION DEERCREST BLOCK / SECTION LOT 141 LOT AREA 0.9849 ACRE SITE CLASS PS DESIGN FLOW 360 L.T.A.R. 0.30 GPD/FT²

Septic Tank: 1000 Gallons; STB 1012 Date 1-16-2000

Pump Tank: Gallons; PT Date

Pump Make: Model Serial No.

Nitrification Field: No Fields 1 Square Feet EQ TO 1200 Linear Feet 300 ±

No Lines FIVE Trench Width 36" Max Trench Bottom Depth 36" Gravel Depth 6" SAND

☑ New System ☐ Repair System Type: I, II, III, IV, V, VI

System Description: 25% REDUCTION GRAVITY

Repair System Description: 25% REDUCTION GRAVITY

Maintenance Agreement Required: ☐ Yes ☑ No

☑ House/Mod. Home No. Bedrooms 3

☐ Mobile Home No. Bathrooms 2

☐ Business No. Employees


☐ Other

☐ Slab ☑ Crawl Space ☐ Basement w/plumbing ☐ Basement wo/plumbing

Water Supply: ☐ Individual ☑ Public ☐ Community


Comments:/Conditions: INSTALL 25% REDUCTION SYSTEM USING FIFTY (50) CHAMBERS OR THIRTY (30) HDS SECTIONS P.L. 200.00' (TOTAL)

INITIAL SITE SKETCH

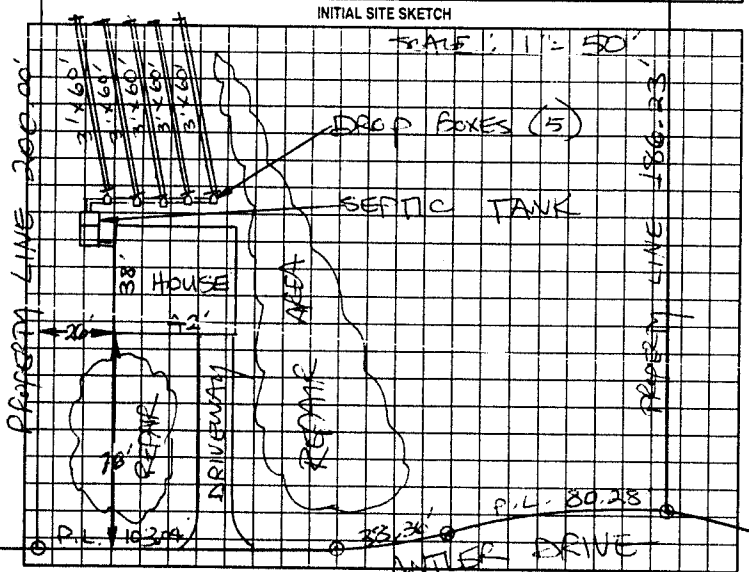

Comments:/Conditions: SEPTIC TANK W/ RISERS INSTALLED USING "POLYLOK" FILTER

AS BUILT SKETCH

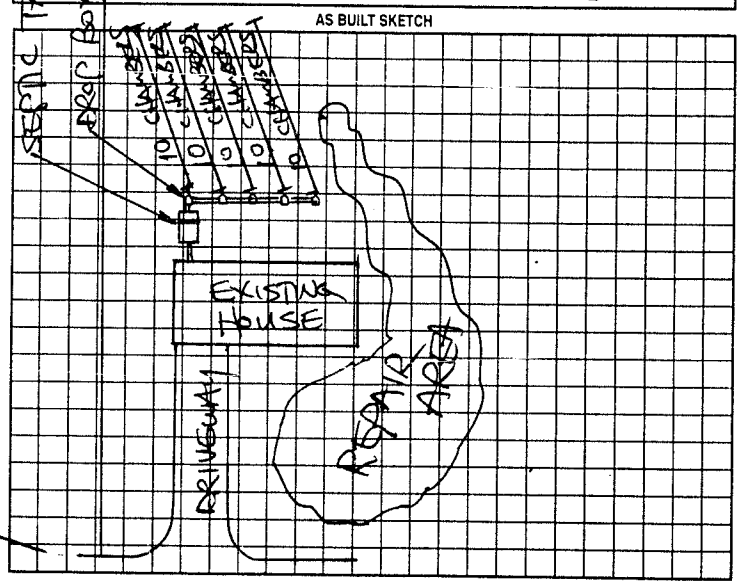

Permit can be suspended or revoked if any false information is supplied toward securing the permit/any unauthorized changes are made to the site/any unauthorized changes are made in the installation of the system. Improvement Permit with plat valid without expiration. Improvement Permit with site plan valid for sixty months. Authorization to Construct is valid for a period equal to that of Improvement Permit – not to exceed sixty months.

Signed: [signature] date 1-21-00 Installed by: STEVE JORDAN

Improvement Permit by: STEVE HEDRICK date 1-21-00 Operation Permit by: STEVE HEDRICK date 4-27-00

Authorization to Construct by: STEVE HEDRICK date 1-21-00 Existing System Inspection by: date

HEALTH DEPT. COPY: WHITE OWNER COPY (FINAL): YELLOW OWNER COPY (INITIAL) PINK