IREDELL COUNTY HEALTH DEPARTMENT

STATESVILLE 704-878-5305 MOORESVILLE 704-664-5281

IMPROVEMENT PERMIT / AUTHORIZATION TO CONSTRUCT / OPERATION PERMIT / EXISTING SYSTEM INSPECTION

PERMIT# 093659 PIN# 4726 61 9062 DATE 1-10-01

OWNER OR CONTRACTOR PERRY, DAVID M. PHONE: Business (704) 539-5169 Home

ADDRESS 332 YORK SPANN RD, HAMPTONVILLE, NC 27020

LOCATION MILLER FARM RD, @ FAWNWOOD, AT END ON ®

SUBDIVISION FAWNWOOD BLOCK / SECTION LOT 14 LOT AREA .53 Ac. SITE CLASS P5 DESIGN FLOW 360 GPD L.T.A.R. 0.3 gpd/ft²

Septic Tank: 1000 Gallons: STB 1012 Date 3-10-01
Pump Tank: Gallons; PT Date
Pump Make: Model Serial No.
Nitrification Field: No Fields 1 Square Feet EQ. TO 1200 Linear Feet 300+
No Lines 6 Trench Width 36" Max Trench Bottom Depth 30" ~~Gravel~~ Depth SAND 6"

☒ New System ☐ Repair System Type: I, II, (III), IV, V, VI
System Description: 25% REDUCTION GRAVITY
Repair System Description: 50% REDUCTION PUMP
Maintenance Agreement Required: ☐ Yes ☒ No ~~GRAVITY~~

☒ House/Mod. Home No. Bedrooms 3
☐ Mobile Home No. Bathrooms 2
☐ Business No. Employees
☐ Other


☐ Slab ☒ Crawl Space ☐ Basement w/plumbing ☐ Basement wo/plumbing

Water Supply: ☐ Individual ☒ Public ☐ Community


Comments/Conditions: ① NO CUTTING OR FILLING OVER DRAINFIELD/REPAIR AREAS ② KEEP ALL DRAINS AWAY FROM DRAINFIELD/REPAIR AREAS ③ MAINTAIN ALL NOTED SETBACKS ④ DRAINLINES TO BE INSTALLED ON CONTOUR

Comments/Conditions: INSTALL 25% REDUCTION SYSTEM USING FIFTY (50) CHAMBERS OR THIRTY (30) HDS SECTIONS
- Septic Tank Marker Installed
Poly Lok Filter Installed

INITIAL SITE SKETCH

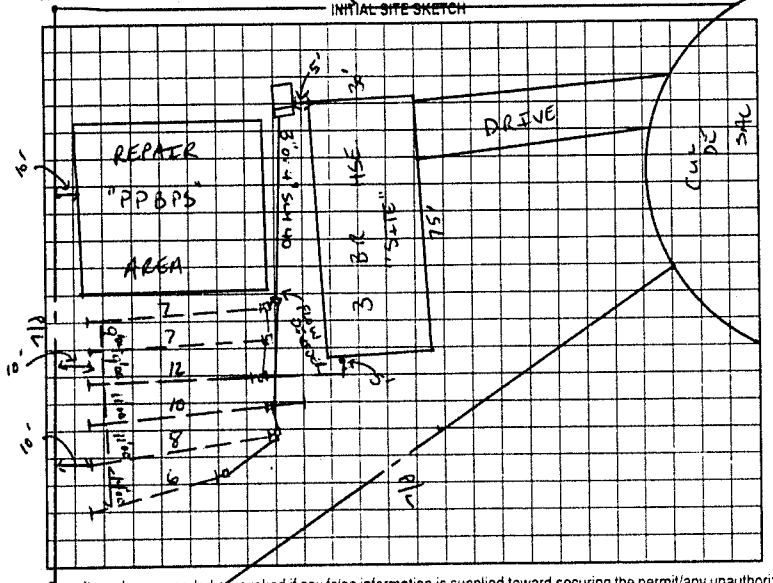

AS BUILT SKETCH

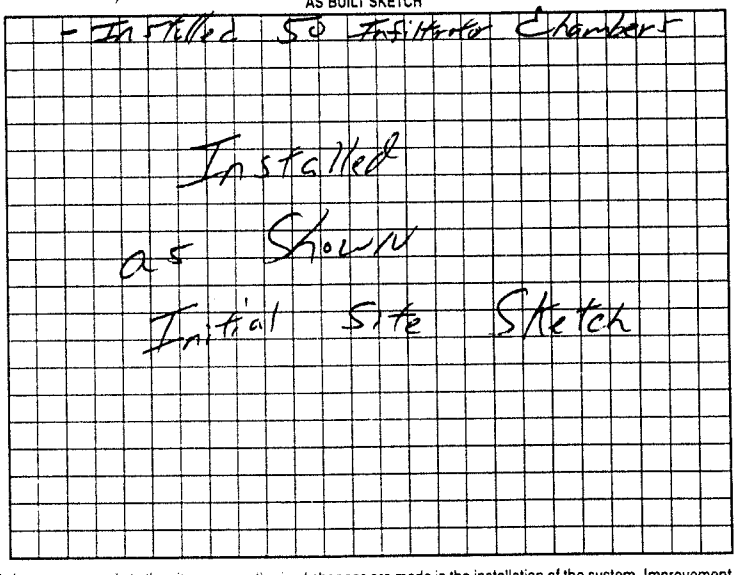

Permit can be suspended or revoked if any false information is supplied toward securing the permit/any unauthorized changes are made to the site/any unauthorized changes are made in the installation of the system. Improvement Permit with plat valid without expiration. Improvement Permit with site plan valid for sixty months. Authorization to Construct is valid for a period equal to that of Improvement Permit – not to exceed sixty months.

Signed: ~~[illegible]~~ David M. Perry date 1-11-01 Installed by: Tommy Frye

Improvement Permit by: STEVE HEDRICK date 1-10-01 Operation Permit by: William O. Johnson date 6/21/01

Authorization to Construct by: STEVE HEDRICK date 1-10-01 Existing System Inspection by: date

HEALTH DEPT. COPY: WHITE OWNER COPY (FINAL): YELLOW OWNER COPY (INITIAL): PINK