113746

IREDELL COUNTY HEALTH DEPARTMENT

STATESVILLE 704-878-5305 (C1) MOORESVILLE 704-664-5281

IMPROVEMENT PERMIT / AUTHORIZATION TO CONSTRUCT / OPERATION PERMIT / EXISTING SYSTEM INSPECTION

(C1)

PERMIT# 106525 PIN# 4726-62-0275 DATE 6-25-02

OWNER OR CONTRACTOR L.C. SUTTON PHONE: Business Home 704-873-1074

ADDRESS 131 D.J. DRIVE, STATESVILLE, NC 28625

LOCATION NC115 N, TL SCOTT CREEK, TL MILLER FARM, TR DOE, TR ELK, TR CARIBOU, 3RD ON RIGHT

SUBDIVISION DEERCRAFT BLOCK / SECTION III LOT 87 LOT AREA 0.54 ACRES SITE CLASS PS DESIGN FLOW 360 L.T.A.R. 0.30 GPD/FT²

Septic Tank: 1000 Gallons; STB 1012 Date 2-1-04

Pump Tank: ____ Gallons; PT ____ Date ____

Pump Make: ____ Model ____ Serial No. ____

Nitrification Field: No Fields 1 Square Feet 1200 Linear Feet 400

No Lines FIVE Trench Width 36" Max Trench Bottom Depth 36" Gravel Depth 12"

☑ New System ☐ Repair System Type: I (II) III IV V VI

System Description: CONVENTIONAL GRAVITY

Repair System Description: 25% REDUCTION, GRAV, Pump

Maintenance Agreement Required: ☐ Yes ☑ No

☑ House/Mod. Home No. Bedrooms 3

☐ Mobile Home No. Bathrooms 2

☐ Business No. Employees ____

☐ Other ____


☐ Slab ☑ Crawl Space ☐ Basement w/plumbing ☐ Basement wo/plumbing

Water Supply: ☐ Individual ☑ Public ☐ Community


Comments:/Conditions: New House plans 78x30 Submitted 6/19/03 - by AAA Building - WJF

Comments:/Conditions: Tuff Tite Filter & ST Marker Installed - deck not built @ time of inspection must be 5ft from ST unless deck completely attached to House.

INITIAL SITE SKETCH SCALE: 1" = 40'

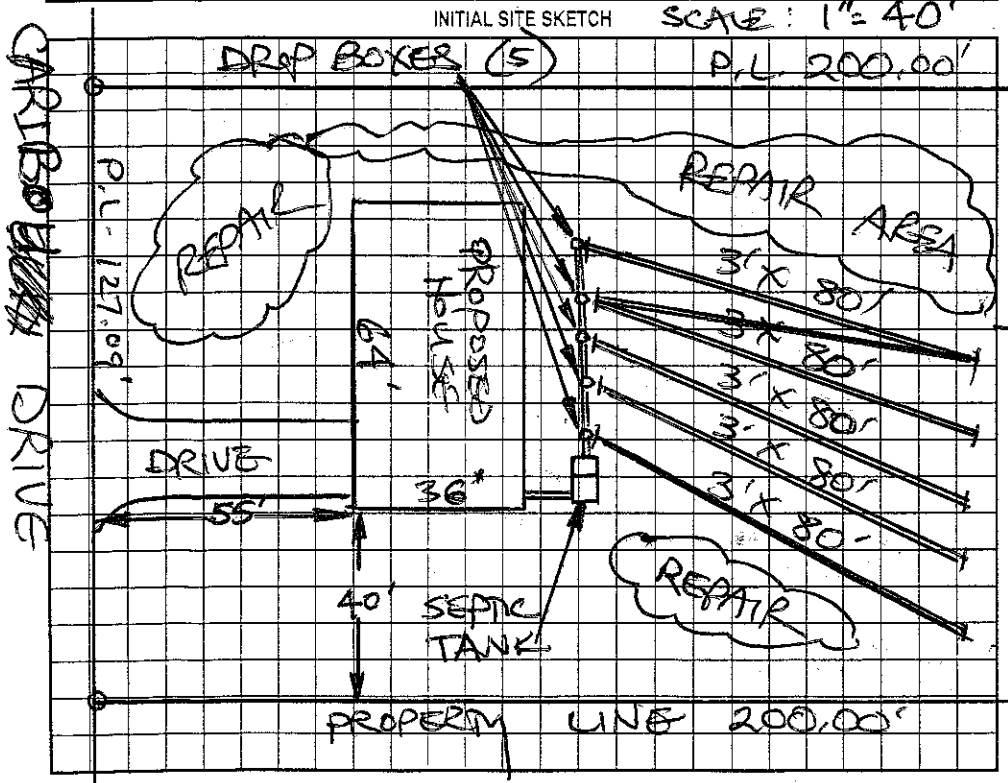

AS BUILT SKETCH

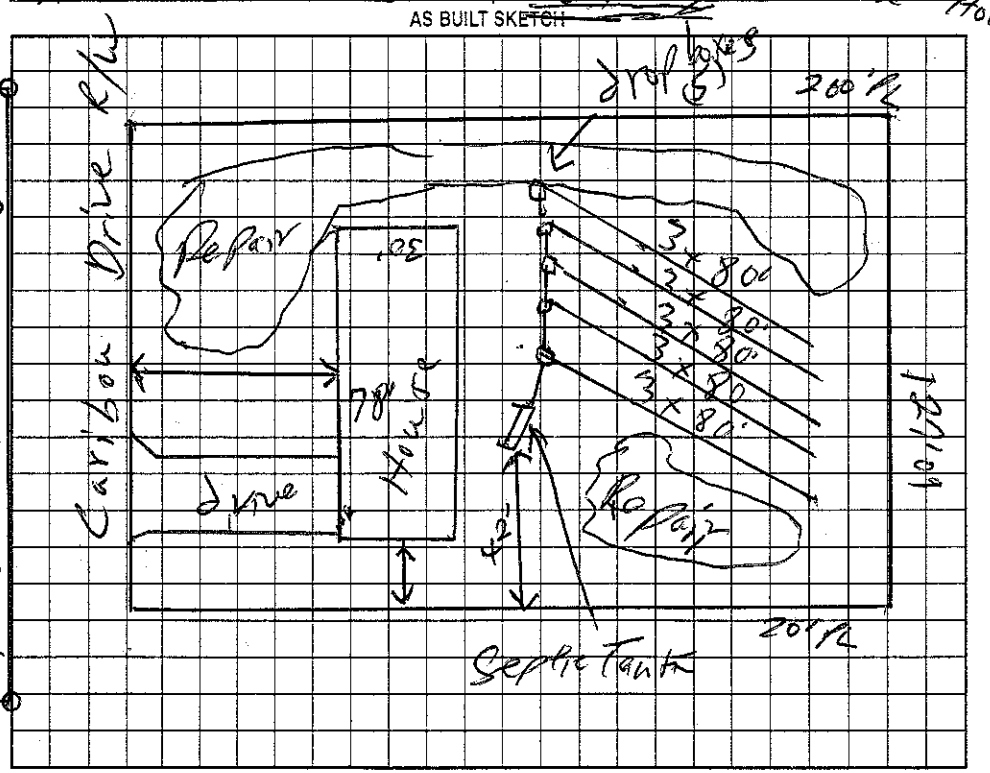

Permit can be suspended or revoked if any false information is supplied toward securing the permit/any unauthorized changes are made to the site/any unauthorized changes are made in the installation of the system. Improvement Permit with plat valid without expiration. Improvement Permit with site plan valid for sixty months. Authorization to Construct is valid for a period equal to that of Improvement Permit – not to exceed sixty months.

Signed: L.C. Sutton date 6-25-02 Installed by: Dale Fox

Improvement Permit by: STEVE HEDRICK date 6-25-02 Operation Permit by: William O. Parker date 7/1/04

Authorization to Construct by: STEVE HEDRICK date 6-25-02 Existing System Inspection by: ____ date ____

HEALTH DEPT. COPY: WHITE OWNER COPY (FINAL): YELLOW OWNER COPY (INITIAL): PINK