IREDELL COUNTY HEALTH DEPARTMENT

STATESVILLE 704-878-5305 MOORESVILLE 704-664-5281

50204

IMPROVEMENT PERMIT / CERTIFICATE OF COMPLETION / OPERATION PERMIT / EXISTING SYSTEM INSPECTION

PROPERTY DESCRIPTION NO. 17764 DATE 2/3/94 TAX MAP NO. 9A-9-A-99

OWNER OR CONTRACTOR A. J. BUILDING CO. PHONE: Business Watershed: ☐ Yes ☒ No

ADDRESS 1068 MOCKSVILLE HWY, STVL, NC 28677 Home 871-0940

LOCATION NC 115 N TL SR 1551 TL SR 1554, TR DOE TRAIL, TR ELK DR, TR CARIBOU, TL WATTS LN, 2nd (L)

SUBDIVISION DEERCROFT BLOCK/SECTION II LOT 91 LOT AREA 110 x 232' SITE CLASS PS DESIGN FLOW 360 L.T.A.R. 0.356PD/FT²

Septic Tank: 1000 Gallons; STB 794 Date 4/20/94
Pump Tank: ____ Gallons; PT ____ Date ____
Pump Make: ____ Model ____ Serial No. ____
Nitrification Field: No Fields 1 Square Feet 1035 Linear Feet 345
No Lines 3 Trench Width 36" Max Trench Bottom Depth 18-36" Gravel Depth 12"

☒ New System ☐ Repair System Type: I (II) III, IV, V, VI
System Description: CONV. GRAVITY
Repair System Description: CONV. GRAVITY
Maintenance Agreement Required: ☐ Yes ☒ No


☒ House/Mod. Home No. Bedrooms 3
☐ Mobile Home No. Bathrooms 2
☐ Business No. Employees ____
☐ Other ____
☐ Slab ☒ Crawl Space ☐ Basement w/plumbing ☐ Basement wo/plumbing

Water Supply:
☐ Individual
☐ Community
☒ Public

Comments: (1) KEEP SYSTEM MINIMUM 5' FROM HOUSE, 10' FROM PROPERTY LINE (2) INSTALL LINES ON CONTOUR, NO DEEPER THAN 36", 9' APART O.C.

Comments:

INITIAL SITE SKETCH

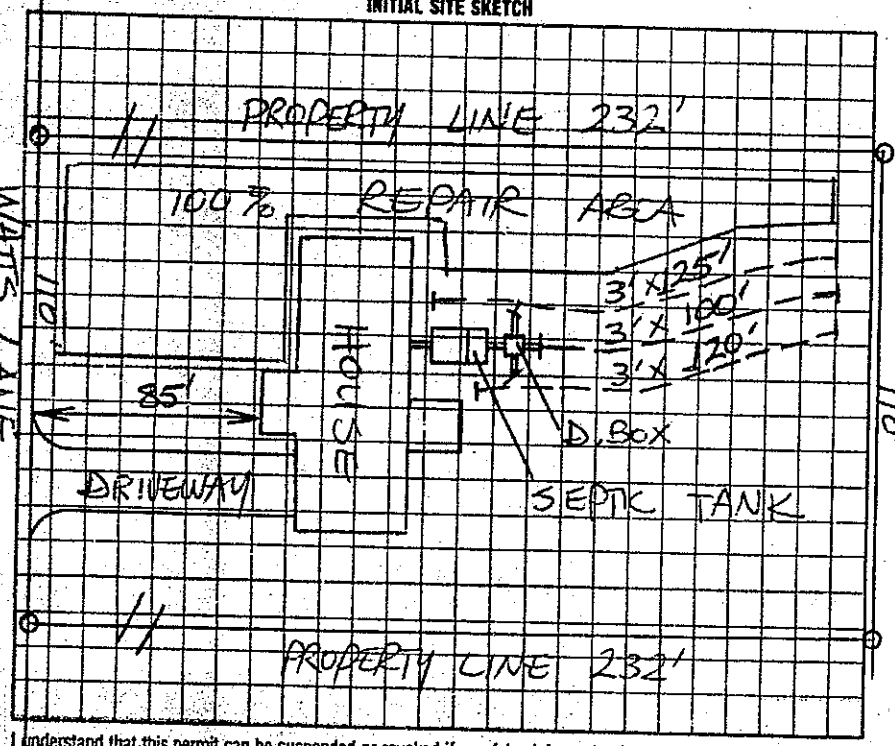

AS BUILT SYSTEM INSTALLED ACCORDING TO INITIAL SITE SKETCH

The location of the proposed SCREENED IN PORCH addition does not appear to impact the existing septic system.

**NOTE: ____

R. STEVE HEDRICK REHS
Date: NOV/9/2010
ICHD-Environmental Health Division

I understand that this permit can be suspended or revoked if any false information is supplied toward securing the permit/any unauthorized changes are made to the site/any unauthorized changes are made in the installation of the system. Improvement Permit is valid for 60 months from date of issuance.

Signed: X Jeffrey E. Whicker

Improvement Permit by: STEVE HEDRICK date 2/3/94

Existing System Inspection by: ____ date ____

Installed by: A-1 BACKHOE

Certificate of Completion by: STEVE HEDRICK date 5/19/94

Operation Permit by: ____ date ____

HEALTH DEPT. COPY: WHITE INSPECTION COPY (FINAL): GREEN OWNER COPY (FINAL): YELLOW INSPECTION COPY (INITIAL): PINK OWNER COPY (INITIAL): GOLD