AJ Building Co. 20292

IREDELL COUNTY HEALTH DEPARTMENT

THIS PERMIT VOIDS PREVIOUS ISSUED 2-8-95

STATESVILLE 704-878-5305 MOORESVILLE 704-664-5281

62072

IMPROVEMENT PERMIT / CERTIFICATE OF COMPLETION / OPERATION PERMIT / EXISTING SYSTEM INSPECTION

PROPERTY DESCRIPTION NO. 20292 DATE 7-11-96 TAX MAP NO. 9A-9-A-96 Watershed: ☐ Yes ☒ No

OWNER OR CONTRACTOR W & W SALES PHONE: Business Home 873-3388

ADDRESS NC115 N, TL SCOTTS CREEK, TL MILLER FARM, TR DOE, TR ELK, TR CARIBOU, TL WATTS AT END ON LEFT,

LOCATION NC115 N, TL SCOTTS CREEK, TL MILLER FARM, TR DOE, TR ELK, TR CARIBOU, TL WATTS CT, AT END ON LEFT

SUBDIVISION DEERCROFT BLOCK / SECTION II LOT 96 LOT AREA 20.75 AC SITE CLASS PS1 DESIGN FLOW 360 L.T.A.R. 0.33 GPD / FT²

Septic Tank: 1000 Gallons: STB 1012 Date 5-17-96

Pump Tank: ____ Gallons; PT ____ Date ____

Pump Make: ____ Model ____ Serial No. ____

Nitrification Field: No Fields 1 Square Feet 1080 Linear Feet 360

No Lines 3 Trench Width 36" Max Trench Bottom Depth 18-36" Gravel Depth 12"

☒ New System ☐ Repair System Type: I (II) III, IV, V, VI

System Description: CONV. GRAVITY

Repair System Description: PUMP TO REPAIR

Maintenance Agreement Required: ☐ Yes ☒ No

☒ House/Mod. Home No. Bedrooms 3

☐ Mobile Home No. Bathrooms 2

☐ Business No. Employees ____

☐ Other ____


☐ Slab ☒ Crawl Space ☐ Basement w/plumbing ☐ Basement wo/plumbing

Water Supply: ☐ Individual ☐ Community ☒ Public

Comments:

Comments:

INITIAL SITE SKETCH

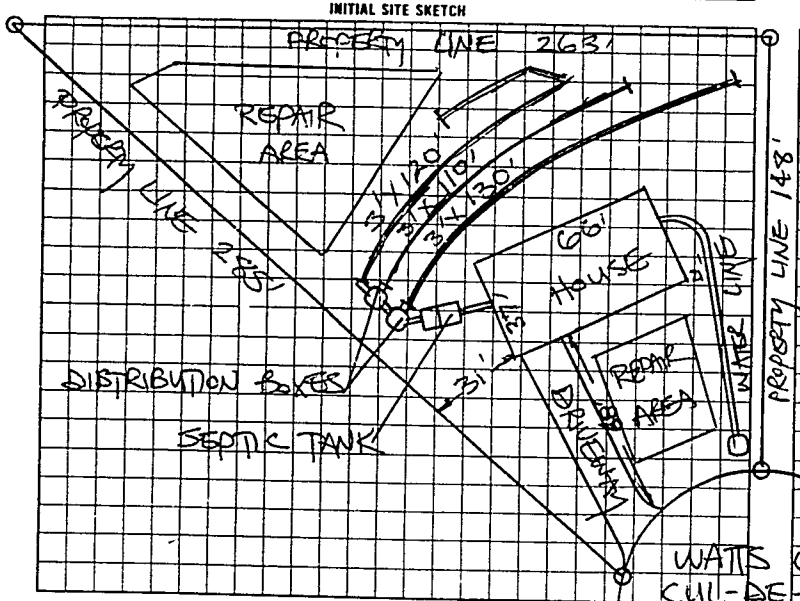

AS BUILT SKETCH

SYSTEM INSTALLED ACCORDING TO INITIAL SITE SKETCH

I understand that this permit can be suspended or revoked if any false information is supplied toward securing the permit/any unauthorized changes are made to the site/any unauthorized changes are made in the installation of the system.

Authorization to Construct is valid five (5) years from date of issuance. Improvement Permit has no expiration date.

Signed [signature]

Improvement Permit by STEVE HENDRICK date 7-11-96

Exempt System Inspection by AUTHORIZATION TO CONSTRUCT: STEVE HENDRICK date 7-11-96

Installed by [redacted] TOMMY FRYE

Certificate of Completion by: ____ date ____

Operation Permit by: STEVE HENDRICK date 10-23-96

HEALTH DEPT COPY WHITE | INSPECTION COPY (FINAL) GREEN | OWNER COPY (FINAL) YELLOW | INSPECTION COPY (INITIAL) PINK | OWNER COPY (INITIAL) GOLD

115

799200