IREDELL COUNTY HEALTH DEPARTMENT

STATESVILLE 704-878-5305 MOORESVILLE 704-664-5281

IMPROVEMENT PERMIT / AUTHORIZATION TO CONSTRUCT / OPERATION PERMIT / EXISTING SYSTEM INSPECTION

PERMIT# 071876 PIN# 4726 62 2083 DATE 2-12-98

OWNER OR CONTRACTOR STANDARD BUILDING CO. PHONE: Business 929-0948 Home 585-2211

ADDRESS 202 HARRIS BRIDGE RD. STONY POINT, NC 28678

LOCATION NC 115 N, TL SCOTTS CREEK, TL MILLER FARM, TR DOE TRAIL, 1ST LOT ON RIGHT

SUBDIVISION DEERCROFT BLOCK / SECTION I LOT 14 LOT AREA 0.51 ACRE SITE CLASS. PS DESIGN FLOW 360 L.T.A.R. 0.30 GPD/FT²

Septic Tank: 1000 Gallons; STB 825 Date 1-2-98
Pump Tank: ____ Gallons; PT ____ Date ____
Pump Make: ____ Model ____ Serial No. ____
Nitrification Field: No Fields 1 Square Feet Eq. To 1200 Linear Feet 300+
No Lines FIVE Trench Width 36" Max Trench Bottom Depth 36" ~~Gravel~~ Depth SAND 6"

☑ New System ☐ Repair System Type: I, II, III, IV, V, VI
System Description: CHAMBERED GRAVITY
Repair System Description: PREV PUMPED
Maintenance Agreement Required: ☐ Yes ☑ No


☑ House/Mod. Home No. Bedrooms 3
☐ Mobile Home No. Bathrooms 2
☐ Business No. Employees ____
☐ Other ____
☐ Slab ☑ Crawl Space ☐ Basement w/plumbing ☐ Basement wo/plumbing

Water Supply: ☐ Individual ☑ Public ☐ Community


Comments:/Conditions: INSTALL FIFTY CHAMBERS IN FIVE EQUAL LENGTH LINES ON CONTOUR AS SHOWN.

Comments:/Conditions:

INITIAL SITE SKETCH SCALE: 1"=40'

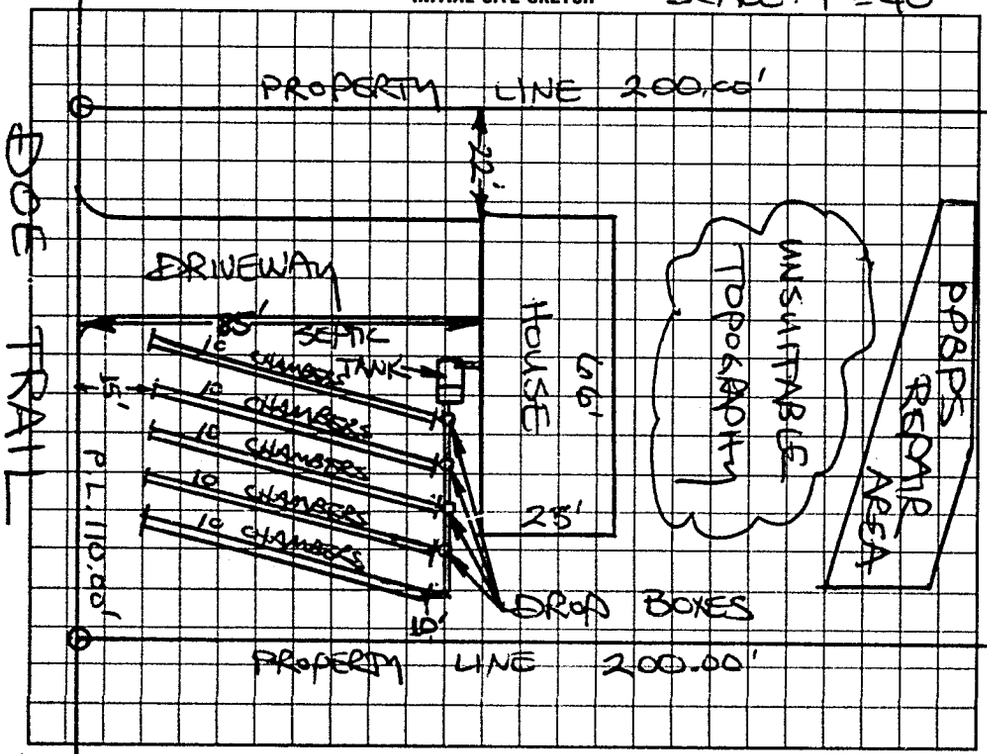

AS BUILT SKETCH

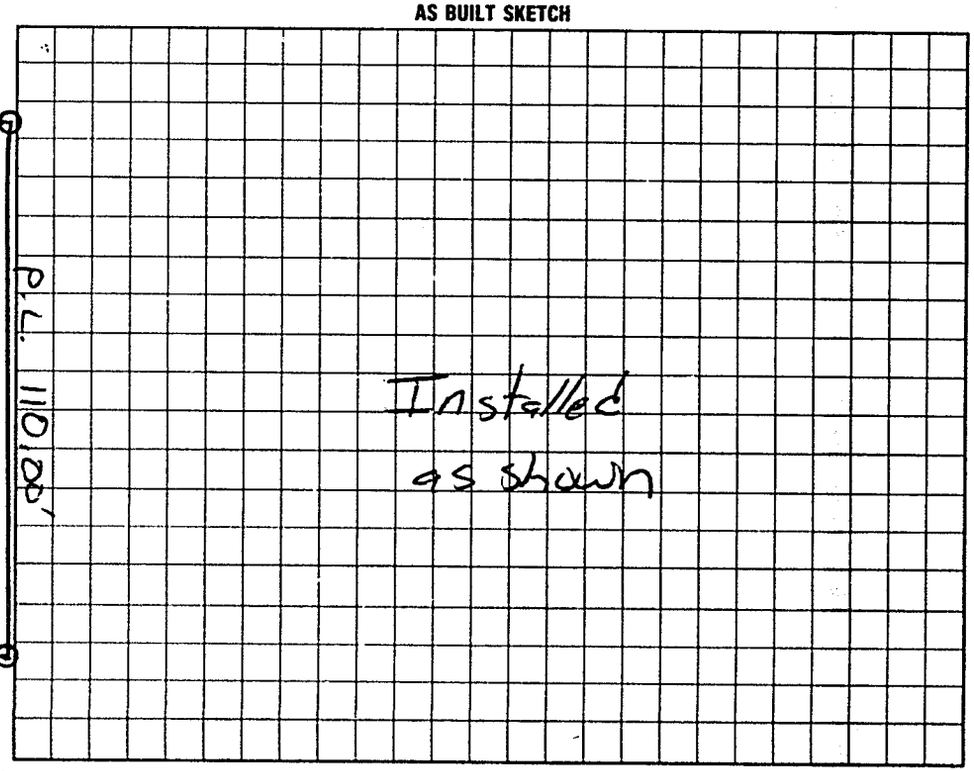

I understand that this permit can be suspended or revoked if any false information is supplied toward securing the permit/any unauthorized changes are made to the site/any unauthorized changes are made in the installation of the system. Improvement Permit with plat valid without expiration. Improvement Permit with site plan valid for sixty months. Authorization to Construct is valid for a period equal to that of Improvement Permit – not to exceed sixty months.

Signed: [signature] date 2-24-98 Installed by: Wayne Clontz

Improvement Permit by: STEVE HENDRICK date 2-12-98 Operation Permit by: Mark Cox REHS date 7-23-98

Authorization to Construct by STEVE HENDRICK date 2-12-98 Existing System Inspection by date

HEALTH DEPT. COPY: WHITE INSPECTION COPY (FINAL): GREEN OWNER COPY (FINAL): YELLOW INSPECTION COPY (INITIAL): PINK OWNER COPY (INITIAL): GOLD

0 0 2 0 0 0