47673

IREDELL COUNTY HEALTH DEPARTMENT

STATESVILLE 704-878-5305 MOORESVILLE 704-664-5281

IMPROVEMENT PERMIT / CERTIFICATE OF COMPLETION / OPERATION PERMIT / EXISTING SYSTEM INSPECTION

PROPERTY DESCRIPTION NO. 1647 DATE 6/14/93 TAX MAP NO. 9A-9-A-13

OWNER OR CONTRACTOR C. ALLEN REAVIS PHONE: Business 873-2271 Home 872-0897

ADDRESS 618 CHAR DRIVE STATESVILLE, NC 28677

LOCATION NC 115 N, TL SCOTTS CREEK RD, TL MILLER FARM RD, TR DOE TRAIL, 13TH LOT ON (R)

SUBDIVISION DEERCROFT BLOCK / SECTION 1 LOT 13 LOT AREA 110'x 200' SITE CLASS. PS L.T.A.R. 0.33 GPD/FT2

Water Supply: ☐ Individual ☐ Community ☑ Public

Septic Tank: 1000 Gallons; STB 358 Date 7/30/93

Pump Tank: ____ Gallons; PT ____ Date ____

Nitrification Field: No Fields 1 Square Feet 1080 Linear Feet 360

No Lines 3 Trench Width 36" Trench Depth 36" Gravel Depth 12"

☑ New System ☐ Repair System Type: I. II. III. IV. V. VI

System Description: CONV, GRAVITY

Repair System Description: CONV, PUMP/GRAV.

Maintenance Agreement Required: ☐ Yes ☑ No

☑ House/Mod. Home ☐ Mobile Home ☐ Business ☐ Other ____

No. Bedrooms 3 No. Bathrooms 2 No. Employees ____

☐ Slab ☑ Crawl Space ☐ Basement w/plumbing ☐ Basement wo/plumbing

Garbage Disposal: ☐ Yes ☑ No

Auto. Dishwasher: ☑ Yes ☐ No


Auto. Washing Machine: ☑ Yes ☐ No

Other ____


Comments (1) DRAINLINES SHALL BE INSTALLED NO DEEPER THAN 36"

(2) SYSTEM CHANGED TO 3 LINES TO KEEP SHALLOW PLACEMENT

INITIAL SITE SKETCH

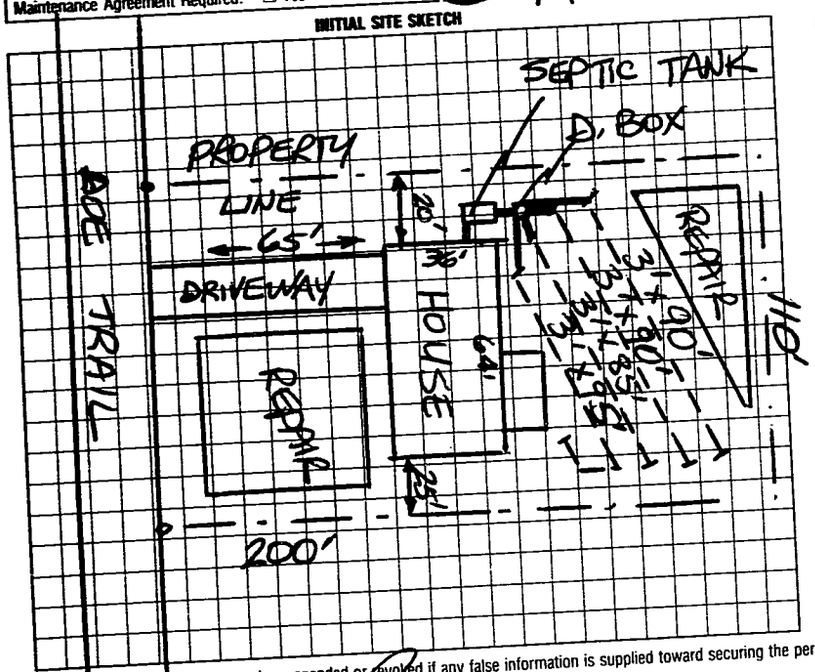

AS BUILT SKETCH

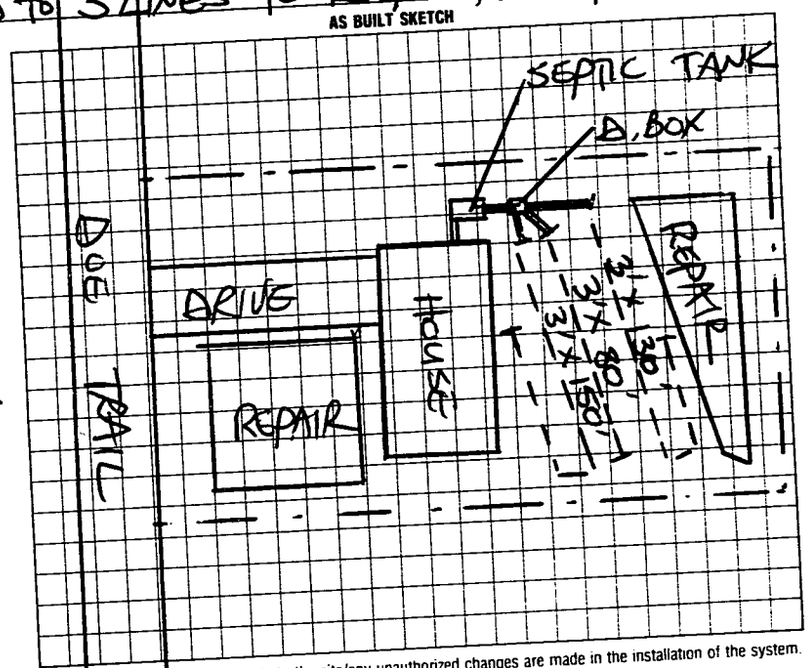

I understand that this permit can be suspended or revoked if any false information is supplied toward securing the permit/any unauthorized changes are made to the site/any unauthorized changes are made in the installation of the system. Improvement Permit is valid for 60 months from date of issuance.

Signed: X C. Allen Reavis

Improvement Permit by: STEVE HEDRICK date 6/14/93

Existing System Inspection by: ____ date ____

Installed by: A-1 BACK HOE

Certificate of Completion by: STEVE HEDRICK date 9/14/93

Operation Permit by: ____ date ____

HEALTH DEPT. COPY: WHITE INSPECTION COPY (FINAL): GREEN OWNER COPY (FINAL): YELLOW INSPECTION COPY (INITIAL): PINK OWNER COPY (INITIAL): GOLD