IREDELL COUNTY HEALTH DEPARTMENT

STATESVILLE 704-878-5305 MOORESVILLE 704-664-5281

IMPROVEMENT PERMIT / CERTIFICATE OF COMPLETION / OPERATION PERMIT / EXISTING SYSTEM INSPECTION

PROPERTY DESCRIPTION NO. 22307 DATE 10-19-95 TAX MAP NO. 9A-9-A-89 Watershed: ☐ Yes ☒ No

OWNER OR CONTRACTOR CHRISTEN HAYZLIP PHONE: Business Home 632-8484

ADDRESS RT. 5, BOX 68, TAYLORSVILLE, NC 28681

LOCATION NC 115 N, TL SCOTTS CREEK, TL MILLER FARM, TR DOE TRAIL, TR ELK DRIVE, TR CARIBOU DRIVE

SUBDIVISION DEERCROFT BLOCK / SECTION II LOT 89 LOT AREA 117X200' SITE CLASS PS DESIGN FLOW 360 L.T.A.R. 0.30 GPD/FT

Septic Tank: 1000 Gallons; STB 1012 Date 3-22-96

Pump Tank: Gallons; PT Date

Pump Make: Model Serial No.

Nitrification Field: No Fields 1 Square Feet 1200 Linear Feet 400

No Lines 6 Trench Width 36" Max Trench Bottom Depth 18-36" Gravel Depth 12"

☒ New System ☐ Repair System Type: I, II, III, IV, V, VI

System Description: CONVENTIONAL GRAVITY

Repair System Description: LOW PRESSURE PIPING

Maintenance Agreement Required: ☐ Yes ☒ No

☒ House/Mod. Home No. Bedrooms 3

☐ Mobile Home No. Bathrooms 2

☐ Business No. Employees

☐ Other


☐ Slab ☐ Crawl Space ☐ Basement w/plumbing ☒ Basement wo/plumbing

Water Supply: ☐ Individual ☐ Community ☒ Public

Comments: ① KEEP SYSTEM MINIMUM 15' FROM BASEMENT, 10' FROM PROPERTY LINE ② INSTALL LINES ON CONTOUR, NO DEEPER THAN 36", 9' MINIMUM APART ON CENTERS ③ NO FILL DIRT ALLOWED OVER DRAINFIELD

Comments:

INITIAL SITE SKETCH

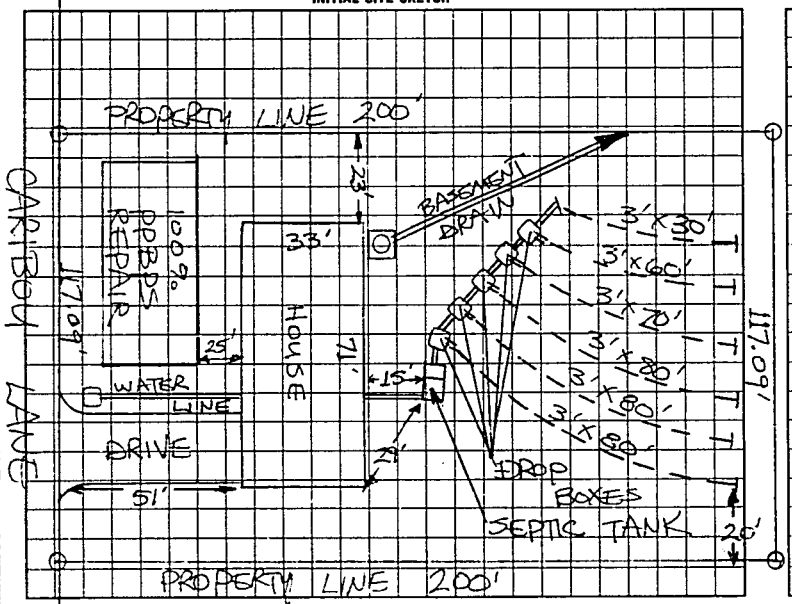

AS BUILT SKETCH

SYSTEM INSTALLED ACCORDING TO INITAL SITE SKETCH

I understand that this permit can be suspended or revoked if any false information is supplied toward securing the permit/any unauthorized changes are made to the site/any unauthorized changes are made in the installation of the system. AUTHORIZATION TO CONSTRUCT IS VALID FIVE (5) YEARS FROM DATE OF ISSUANCE. IMPROVEMENT PERMIT HAS NO EXPIRATION DATE.

Signed: [signature]

Improvement Permit by: STEVE HEDRICK date 10-19-95

~~Existing System Inspection by:~~ AUTHORIZATION TO CONSTRUCT BY: STEVE HEDRICK date 10-19-95

Installed by: TOMMY COTHREN

~~Certificate of Completion by:~~ date

Operation Permit by: STEVE HEDRICK date 6-11-96

HEALTH DEPT. COPY: WHITE INSPECTION COPY (FINAL): GREEN OWNER COPY (FINAL): YELLOW INSPECTION COPY (INITIAL): PINK OWNER COPY (INITIAL): GOLD

LL 9000