ICHD - ENVIRONMENTAL HEALTH DIVISION

Statesville Office (704) 878-5305 Mooresville Office (704) 660-3625 PERMIT # AP 329006

SEPTIC: IMPROVEMENT PERMIT / AUTHORIZATION TO CONSTRUCT / OPERATION PERMIT / EXISTING SYSTEM

PIN # 4726 -- 62 -- 4234

APPLICANT/OWNER: Jacob Gurley APPLICANT ADDRESS: 124 Caribou Dr

SITE ADDRESS: 124 Caribou Dr Statesville 28625 PHONE: 336-708-0300 ALT. PHONE 828-514-3557


SITE DIRECTIONS: 115 - Scotts Creek - Miller Farm - Doe trail - Elk - Caribou SAP CONTROLLED: ☐ YES ☐ NO

SUBDIVISION: Deercroft @ Granville Grant SECTION: 2 LOT # 90 LOT AREA: DESIGN FLOW: 360 gpd L.T.A.R.: 0.25

Septic Tank	EX	(gal)	STB	Date	☐ New System	☐ Repair	☐ Expansion	System Type: I II (III) IV V VI	☒ Residence	No. Bedrooms	3	Water Supply
Pump Tank		(gal)	PT	Date	System Description:	EXISTING			☐ Business	No. Persons	6	☐ Private
Pump Make		Model		Serial #	Repair System Description:	EXISTING			☐ Other	No. Employees		☒ Public
# Nitrification Fields	EX	# Lines	EX	Linear Ft EX	Maintenance Agreement Required:	☐ YES	☒ NO		☐ Slab	☒ Crawl Space		☐ Community
Trench Width	EX	Trench Bottom Depth(Low side)	EX	Gravel Depth EX	☒ GRAVITY	☐ PRESSURE			☐ Basement w/plumbing	☐ Basement w/o plumbing		

Comments / Conditions: System appeared to be working at time of inspection.

INITIAL SITE SKETCH

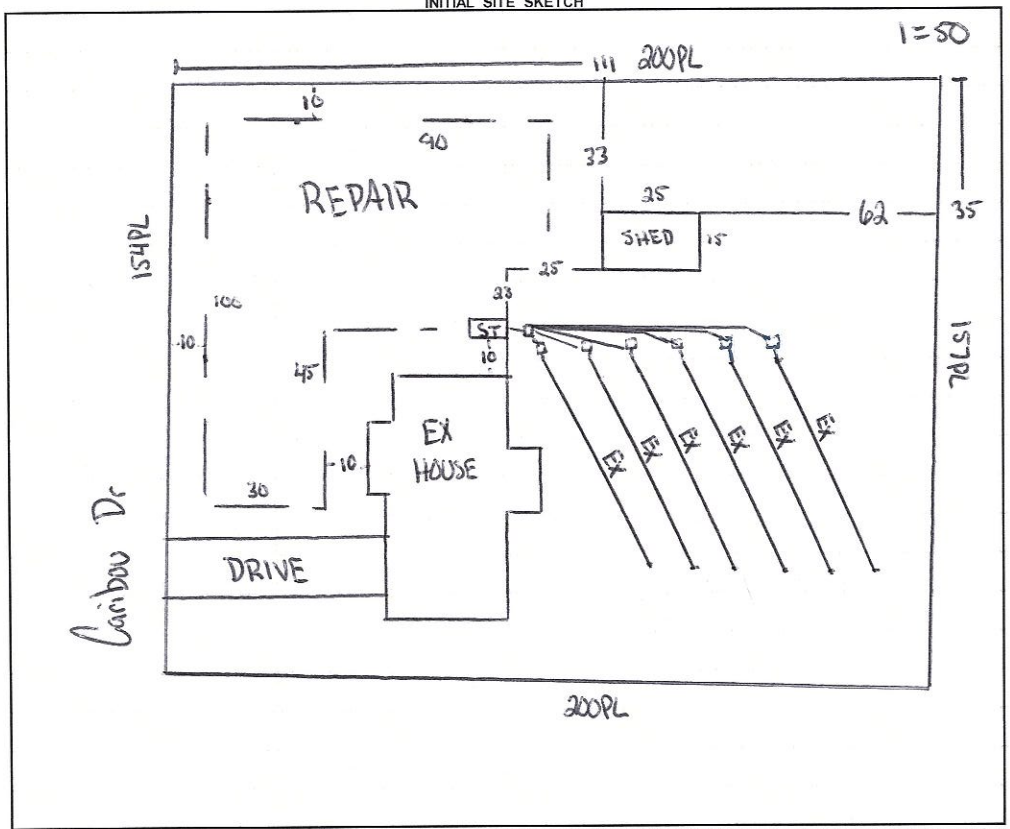

AS BUILT SKETCH

FOR SEPTIC FINAL INSPECTION CALL: 704-664-3703 between 8am-9am the day the inspection is needed. Be sure to speak with an inspector to confirm your time.

Permit can be suspended or revoked if any false information is supplied toward securing the permit / any unauthorized changes are made to the site / any unauthorized changes are made in the installation of the system. **CONTACT A LOCATOR SERVICE PRIOR TO ANY EXCAVATION**

☐ **IMPROVEMENT PERMIT** *with plat valid without expiration.* ☐ **IMPROVEMENT PERMIT** *with site plan valid for 60 mos.* ☐ **AUTHORIZATION TO CONSTRUCT** *valid for period equal to IMPROVEMENT PERMIT--not to exceed 60 mo.*

Owner / Applicant Signature: Jacob Gurley Date: 6/23/2022 Installed by:

IMPROVEMENT PERMIT by: Date: OPERATION PERMIT by: Date:

AUTHORIZATION TO CONSTRUCT by: Date: Existing System Inspected by: Cy Wil Date: 6/21/22

FOR SEPTIC FINAL INSPECTION: CALL 704-664-3703 between 8am-9am the day the inspection is needed.

RECEIVED JUN 3 - 2022

CW

Paid $250.00

APPLICATION MUST BE FILLED OUT COMPLETELY & BE LEGIBLE OR IT WILL NOT BE PROCESSED

AP-329006

Iredell County Health Department – Environmental Health Division

PAGE 1: *APPLICATION FORM*

Application For: ( ) New Well Permit ( ) Well Repair Permit ( ) Well Abandonment
( ) Septic Improvement Permit (X) Authorization to Construct ( ) Existing System Inspection ( ) Septic System Repair

THE ABOVE PERMIT DOCUMENTS WILL BECOME INVALID IF INFORMATION PROVIDED ON THIS APPLICATION IS FALSIFIED OR CHANGED, OR IF THE SITE IS ALTERED. THE IMPROVEMENT PERMIT IS VALID FOR EITHER 60 MONTHS OR WITHOUT EXPIRATION DEPENDING UPON DOCUMENTATION SUBMITTED. APPLICATION WITH SITE PLAN 60 MONTHS. APPLICATION WITH COMPLETE, SCALED PLAT WITHOUT EXPIRATION. SEE 15A NCAC 18A .1937(f) FOR DETAILS.

Page 2: *Site Plan Worksheet* form MUST accompany this application

The following optional attachments may also be submitted: ( ) Survey Plat, scaled no more than 1 inch = 60 feet ( ) Custom Site Plan, scaled no more than 1 inch = 60 feet

Place an (X) beside whichever is submitted if applicable

Applicant Information: (PRINT CLEARLY)

Applicant Name: Jacob Gurley Address: 124 Caribou Drive Zip: 28625
Applicant Email: jrgcmp16@gmail.com Phone: 336-708-0300 Alt. Phone: 828-514-3557
Owner Name: Jacob Gurley Address: 124 Caribou Drive Zip: 28625
Owner Email: jrgcmp16@gmail.com Phone: 828-514-3557 Alt. Phone: 336-708-0300

Property Information:

Street Address: 124 Caribou Drive Statesville, NC 28625
Subdivision Name: DeerCroft Section/Phase: _____ Lot Number: 90
Driving Directions: From Hwy 115 from I40 turn ~~right~~ Left onto Scotts creek road. Continue until miller farm road take a left. Continue 2 Miles turn right onto Dee trail lane right onto Elvy, then right onto Caribou Drive. Last house on right.

Site Development Information: *(check or complete ALL that apply)*

(X) New Single Family Residence 1270 Square Feet. already existing
( ) New Multi-Family Residence
( ) Accessory Building
( ) Bedroom(s) Addition
( ) Repair to failing septic system ___ Tank ___ Drain lines Describe Problem: _____
Maximum Number of Bedrooms: 3
Maximum Number of Occupants: 2 current
( ) Swimming Pool
(X) Other Addition/Structure: Metal Building

CHECK FOUNDATION TYPE

(X) Crawl Space Foundation
(X) Concrete Slab Foundation – will be adding
( ) Basement with Plumbing
( ) Basement without Plumbing

Non-Residential Site Development: Type of Business: Building A Gunsmithing Business
Square Footage of Building: 450 Max. Number of Employees: 1 Max. Number of Seats/Beds/Other: _____

Water Supply: ( ) Replacement Well – Reason: _____
( ) Multi-connection Well Number of Houses: _____ Number of Persons: _____
( ) New Well ( ) Existing Well ( ) Community Well (X) City Water County ( ) Other Public Water

Desired Septic System Type: *(you may rank in order of preference)* Year existing system installed: 2000
(X) No Preference ( ) Alternative ( ) Conventional ( ) Innovative ( ) Modified Conventional ( ) Other: _____

Please answer the following to the best of your ability:

( ) Yes (X) No Does the site contain any jurisdictional wetlands?
( ) Yes (X) No Is any non-domestic sewage (i.e. industrial) to be generated?
( ) Yes (X) No Is the site subject to approval by any other public agency?

I have read this application and certify that the information provided herein is true, complete, and correct. Authorized county and state officials are granted right of entry to conduct necessary inspections to determine compliance with applicable laws and rules. I understand that I am solely responsible for the proper identification and labeling of all property lines and corners and making the site accessible so that a complete site evaluation can be performed.

Signature: Jacob Gurley 5/30/2022
Property owner or owner's legal representative signature (SIGNATURE REQUIRED) DATE

IREDELL COUNTY DEPARTMENT OF ENVIRONMENTAL HEALTH

DOCUMENTATION TO AUTHORIZE AN OWNER'S LEGAL REPRESENTATIVE

(Check and sign only ONE of the options below)

☒ **1. * APPLICANT AND OWNER ARE THE SAME. *** *(Sign here)* Jacob Gulley

Applications for permits require the "signature of the owner or owner's legal representative" (15A NCAC 18A .1937). If the owner does not sign the application himself or herself, they can submit any one of the following documents to designate their legal representative: *Power of Attorney; Real Estate Contract; Estate executor; Bankruptcy trustee; Court ordered guardianship*
In the absence of the above documentation, the property owner may provide the local health department with documentation that designates a legal representative. A property owner may:
Complete this form to document his or her legal representative, or provide his or her own form that contains the information in this form. If there are multiple property owners, then all property owners must sign the form that designates a legal representative.
By signing a form that designates a legal representative for purposes of 15A NCAC 18A .1937, the property owner authorizes that representative to act on their behalf in matters pertaining to the application and permitting process, including signing or receiving any application, document or permit. The owner retains full responsibility to meet all permit conditions specified by the local health department.

☐ **2.** I, _____, am the legal owner(s) of the property located at _____, identified as PIN (Parcel Identification Number)_____, located in Iredell County, North Carolina.

I do hereby authorize **(print legal representative/company name)** _____, _____, to act as an agent on my behalf in applying for/signing/obtaining any of the documents described below.

- Application for Improvement Permit (IP) / Authorization to Construct (AC)
- Improvement Permit (IP) / Authorization to Construct (AC)
- Application for soil-site evaluation (new/repair)
- Application/permit for private drinking water well/well abandonment
- Application for Compliance Inspection

I agree to abide by all decisions and/or conditions between the legal representative acting on my behalf and the Iredell County Department of Public Health, Environmental Health Division.


_____ 6/23/2022
Signature of Owner(s) Date

Mooresville - Environmental Health
Fax: 704-662-3239
610 E. Center Avenue, Mooresville, NC 28115

Statesville - Environmental Health
ronda.hart@co.iredell.nc.us
Fax: 704-871-3483
349 N. Center Street, Statesville, NC 28677

IREDELL COUNTY HEALTH DEPARTMENT
ENVIRONMENTAL HEALTH DIVISION
PAGE 2: *SITE PLAN WORKSHEET*

SEE THE "SAMPLE SITE PLAN" BELOW. INCOMPLETE SITE PLANS WILL BE RETURNED TO YOU FOR COMPLETION AND MAY RESULT IN A DELAY IN THE ISSUANCE OF YOUR SEPTIC SYSTEM PERMIT!!!

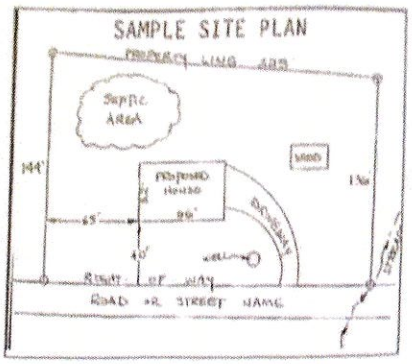

Place an (X) beside each item as you complete the site plan:


- (X) Property Line measurements are clearly identified
- (X) All proposed structures are indicated
- (X) Front and side setbacks from property line
- N/A( ) Preferred driveway location and well location
- (X) Area you prefer your septic system to be placed — already have one
- (X) North arrow, or other sufficient indicator of direction

Circle N/A on the following if appropriate:

- Location of septic systems and wells within 100' of your property — N/A
- Location of easements and rights of ways on your property — N/A
- Location of any designated wetlands on the property — N/A

USE THIS SPACE TO DRAW YOUR SITE PLAN

Show: proposed house or business footprint, wells, water lines, patios, pools and decks, and any other item that will occupy space on the site

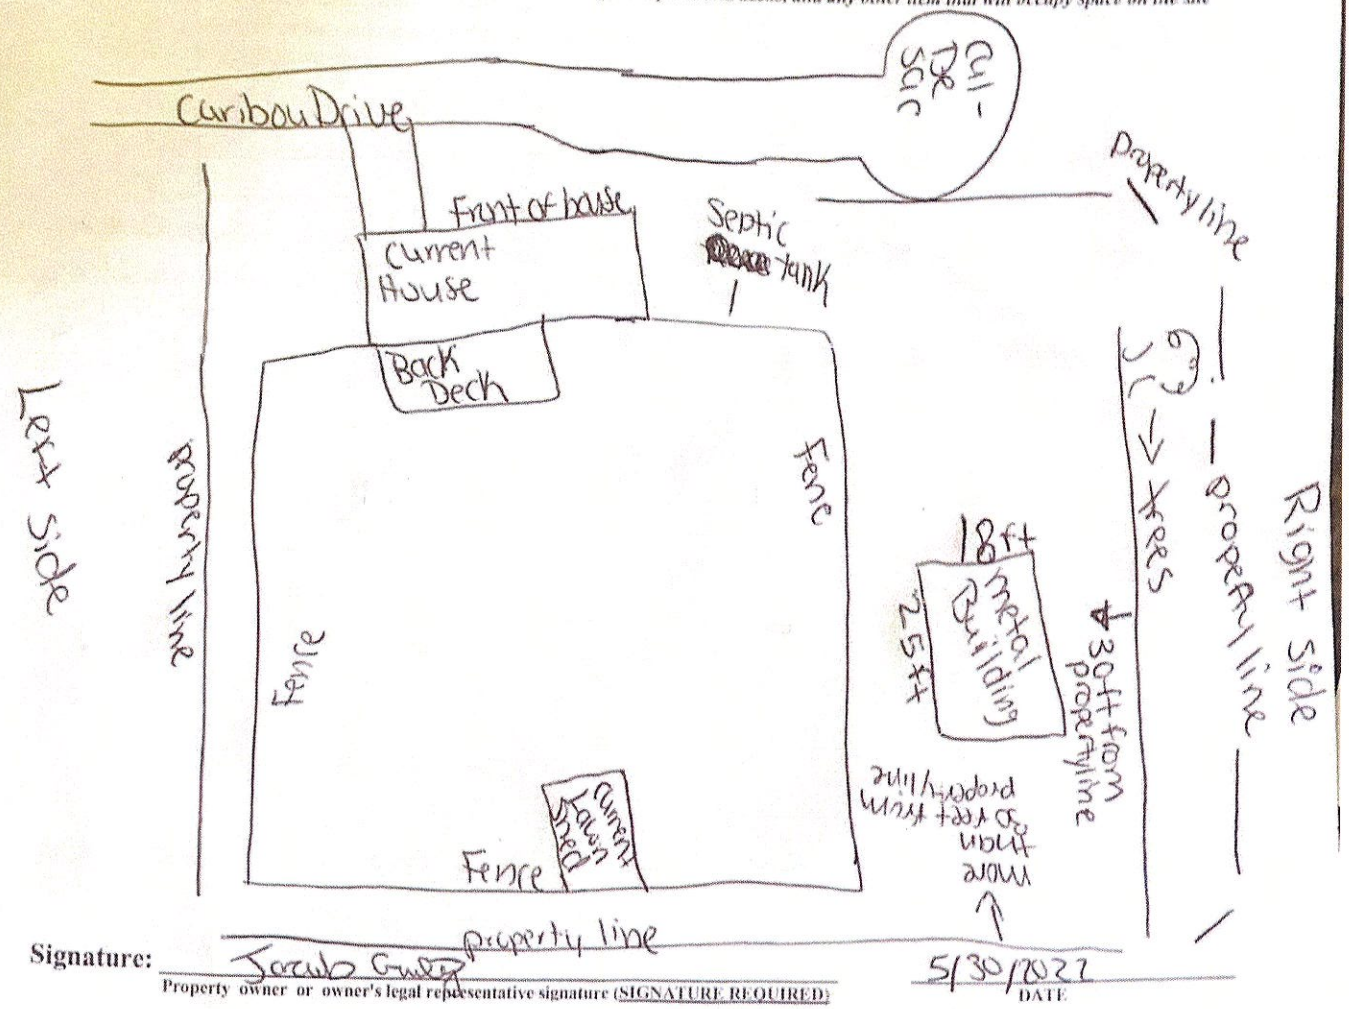

Signature: Jacob Cuda — 5/30/2022

Property owner or owner's legal representative signature (SIGNATURE REQUIRED) — DATE

IREDELL COUNTY HEALTH DEPARTMENT

STATESVILLE 704-878-5305 MOORESVILLE 704-664-5281

IMPROVEMENT PERMIT / AUTHORIZATION TO CONSTRUCT / OPERATION PERMIT / EXISTING SYSTEM INSPECTION

PERMIT# 087320 PIN# 4726 62 4234 DATE 1-21-00

OWNER OR CONTRACTOR SCOTT JOHNSON PHONE: Business Home 871-8732

ADDRESS 411 BROOKDALE DRIVE STATESVILLE, NC 28677

LOCATION NC 115 N, TL SCOTTS CREEK, TL MILLER FARM, TR DOE TRAIL, TR ELK, TR CARIBOU, LOT ON (R) AT END

SUBDIVISION DEERCROFT BLOCK / SECTION II LOT 90 LOT AREA 0.5757 AC SITE CLASS PS DESIGN FLOW 360 L.T.A.R. 0.25 GPD/SF

Septic Tank: 1000 Gallons: STB 1012 Date 2-13-00

Pump Tank: Gallons: PT Date

Pump Make: Model Serial No.

Nitrification Field: No Fields 1 Square Feet 850 to 1440 Linear Feet 360+

No Lines SIX Trench Width 36" Max Trench Bottom Depth 36" Depth SAND 6"

☑ New System ☐ Repair System Type: I, II, III, IV, V, VI

System Description: 25% REDUCTION GRAVITY

Repair System Description: 25% REDUCTION PUMP

Maintenance Agreement Required: ☐ Yes ☑ No

☑ House/Mod. Home No. Bedrooms 3

☐ Mobile Home No. Bathrooms 2

☐ Business No. Employees

☐ Other


☐ Slab ☑ Crawl Space ☐ Basement w/plumbing ☐ Basement wo/plumbing

Water Supply: ☐ Individual ☑ Public ☐ Community


Comments/Conditions: ① REMOVE FILL MATERIAL DOWN TO NATURAL GRADE ② INSTALL 25% REDUCTION SYSTEM USING SIXTY (60) CHAMBERS OR THIRTY-SIX (36) HDS SECTIONS AS SHOWN

Comments/Conditions: SEPTIC TANK W/ RISERS INSTALLED USING "POLY LOK" FILTER

INITIAL SITE SKETCH

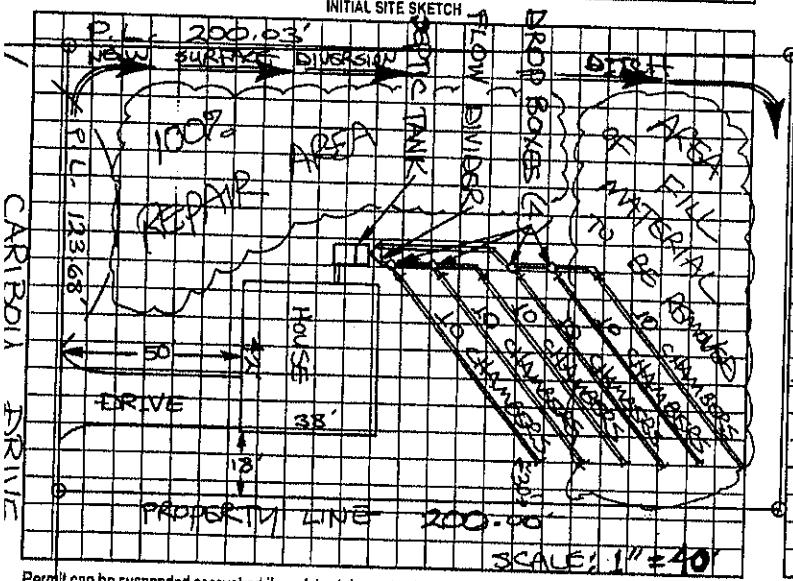

AS BUILT SKETCH

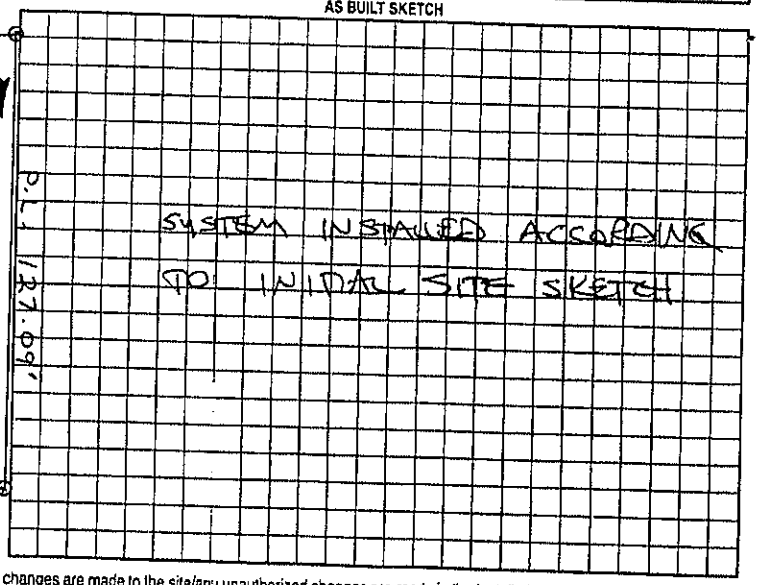

CARIBOU DRIVE

Permit can be suspended or revoked if any false information is supplied toward securing the permit/any unauthorized changes are made to the site/any unauthorized changes are made in the installation of the system. Improvement Permit with plat valid without expiration. Improvement Permit with site plan valid for sixty months. Authorization to Construct is valid for a period equal to that of Improvement Permit - not to exceed sixty months.

Signed: _____ date 1-24-00

Improvement Permit by: STEVE HEDRICK date 1-21-00

Authorization to Construct by: STEVE HEDRICK date 1-21-00

Installed by: WES LYTTON

Operation Permit by: STEVE HEDRICK date 6-14-2000

Existing System Inspection by: _____ date _____

HEALTH DEPT. COPY: WHITE OWNER COPY (FINAL): YELLOW OWNER COPY (INITIAL): PINK