#46994 (REPAIR)

6/2/97 4:30 Dennis Gallhe

IREDELL COUNTY HEALTH DEPARTMENT

STATESVILLE 704-878-5305 MOORESVILLE 704-664-5281

IMPROVEMENT PERMIT / CERTIFICATE OF COMPLETION / OPERATION PERMIT / EXISTING SYSTEM INSPECTION

PROPERTY DESCRIPTION NO. 24092 DATE 7-24-96 TAX MAP NO. 9A-A-34 (PART OF) Watershed: ☐ Yes ☑ No

OWNER OR CONTRACTOR CRANDALL & O'BRIEN CONST. PHONE: Business Home 871-1536

ADDRESS 310 TREEBARK RD. STATESVILLE, NC 28677

LOCATION NC 115 N TL SCOTTS CREEK RD TL HYDE LANE, 5TH LOT ON RIGHT

SUBDIVISION HAMPTON GLEN BLOCK / SECTION II LOT 30' LOT AREA 16,000 FT² SITE CLASS. PS DESIGN FLOW 360 L.T.A.R. 0.3 GPD/FT²

Septic Tank: 1000 Gallons; STB 794-D&167 Date 7/26/96 ☑ New System ☐ Repair System Type: I, II, III, IV, V, VI

Pump Tank: ____ Gallons; PT ____ Date ____ System Description: CHAMBERED GRAVITY

Pump Make: ____ Model ____ Serial No. ____ Repair System Description: PBBPS PUMP FED

Nitrification Field: No Fields 1 Square Feet PER TO 1200 Linear Feet 300± Maintenance Agreement Required: ☐ Yes ☑ No

No Lines FIVE Trench Width 36" Max Trench Bottom Depth 36" Gravel Depth N/A ☐ Slab ☑ Crawl Space ☐ Basement w/plumbing ☐ Basement wo/plumbing

☑ House/Mod. Home No. Bedrooms 3 ☐ Mobile Home No. Bathrooms 2 ☐ Business No. Employees ____ ☐ Other ____


Water Supply: ☐ Individual ☐ Community ☑ Public

L.T.A.R. DETERMINED BY TONEY JACOBS


Comments: (1) TRENCH SIDEWALLS TO BE SCARIFIED WITH HANDTOOL OR BACKHOE & TO BE INSPECTED PRIOR TO INSTALLING CHAMBERS (2) INSTALL 50 CHAMBERS IN FIVE LINES AS SHOWN,

Comments:

INITIAL SITE SKETCH SCALE = 1" = 30'

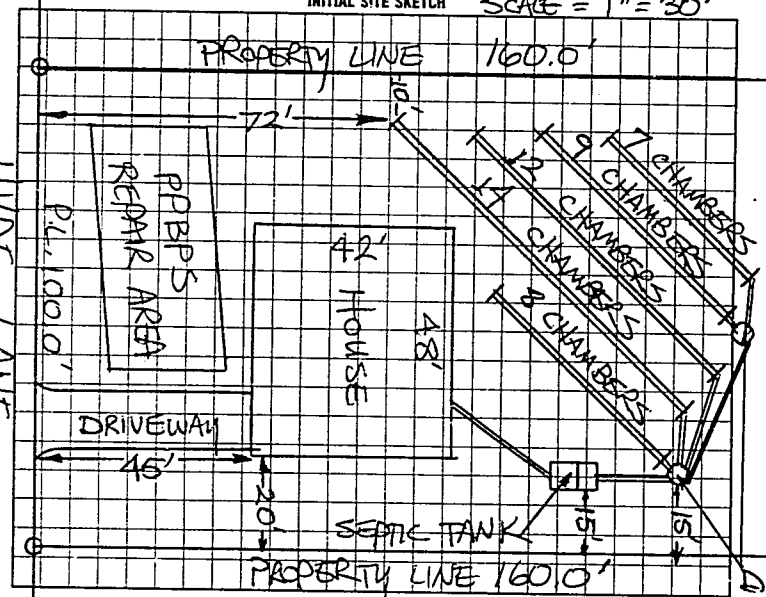

AS BUILT SKETCH

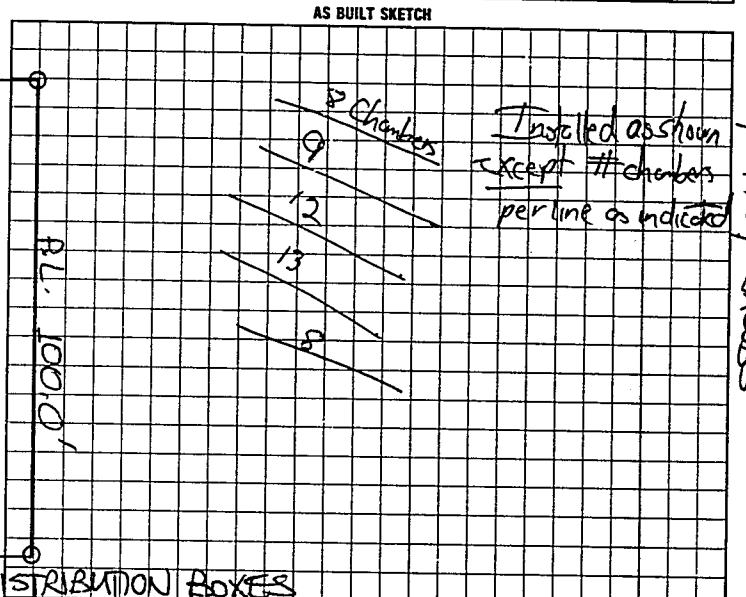

I understand that this permit can be suspended or revoked if any false information is supplied toward securing the permit/any unauthorized changes are made to the site/any unauthorized changes are made in the installation of the system. AUTHORIZATION TO CONSTRUCT IS VALID FIVE YEARS FROM DATE OF ISSUANCE. IMPROVEMENT PERMIT & SITE PLAN IS VALID FOR FIVE YEARS.

Signed: Dick Crandall

Improvement Permit by: STEVE HEDRICK date 7-24-96

AMDT: TO CONST. Existing System Inspection by: STEVE HEDRICK date 7-24-96

Installed by: A-1 Backhoe

~~Certificate of Completion by~~ ____ date ____

Operation Permit by: [signature] date 9/18/96

HEALTH DEPT. COPY: WHITE INSPECTION COPY (FINAL): GREEN OWNER COPY (FINAL): YELLOW INSPECTION COPY (INITIAL): PINK OWNER COPY (INITIAL): GOLD