IREDELL COUNTY HEALTH DEPARTMENT

STATESVILLE 704-878-5305 MOORESVILLE 704-664-5281

64225

IMPROVEMENT PERMIT / CERTIFICATE OF COMPLETION / OPERATION PERMIT / EXISTING SYSTEM INSPECTION

PROPERTY DESCRIPTION NO. 24331 DATE 9-7-96 TAX MAP NO. 9A-A-34 (PART OF) Watershed: ☐ Yes ☒ No

OWNER OR CONTRACTOR CRANDALL & O'BRIEN CONST. PHONE: Business Home 871-1536

ADDRESS 310 TREEBARK ROAD STATESVILLE, NC 28677

LOCATION NC 115 N, TL SCOTTS CREEK RD, TL HYDE LANE, 2ND LOT ON RIGHT

SUBDIVISION HAMPTON GREEN BLOCK / SECTION II LOT 32 LOT AREA 16,000 FT² SITE CLASS PS DESIGN FLOW 360 L.T.A.R. 0.30 GPD/FT²

Septic Tank: 1000 Gallons; STB 1012 Date 10-8-96

Pump Tank: Gallons; PT Date

Pump Make: Model Serial No.

Nitrification Field: No Fields 1 Square Feet EQ. TO 1200 Linear Feet 300±

No Lines FIVE Trench Width 36" Max Trench Bottom Depth 28-36" Gravel Depth N/A

☒ New System ☐ Repair System Type: I, II, III, IV, V, VI

System Description: CHAMBERED GRAVITY

Repair System Description: CHAMBERED GRAVITY

Maintenance Agreement Required: ☐ Yes ☒ No

☒ House/Mod. Home ☐ Mobile Home ☐ Business ☐ Other

No. Bedrooms 3 No Bathrooms 2 No. Employees


☐ Slab ☒ Crawl Space ☐ Basement w/plumbing ☐ Basement wo/plumbing

Water Supply: ☐ Individual ☐ Community ☒ Public


Comments: ① INSTALL 50 CHAMBERS IN FIVE EQUAL LENGHT LINES AS SHOWN USING TWO DISTRIBUTION BOXES FOR SERIAL DISTRIBUTION ② INSTALL LINES 28" TO 36" DEEP

Comments:

INITIAL SITE SKETCH

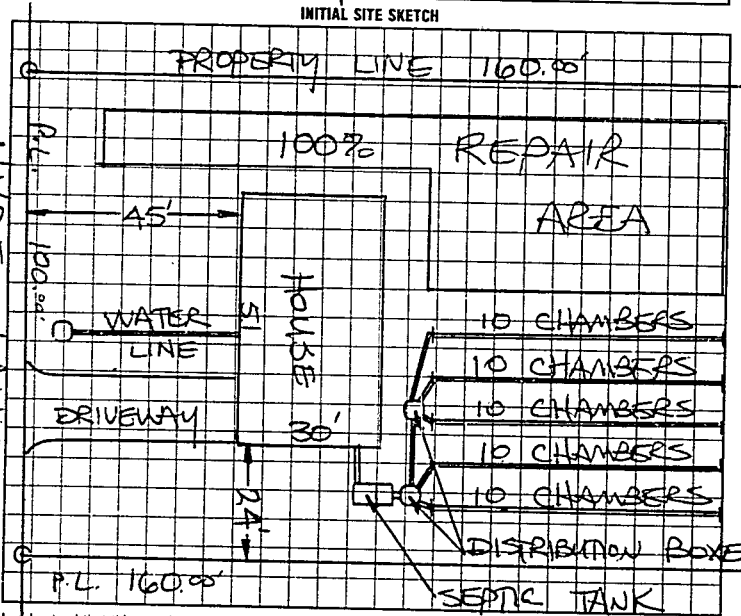

AS BUILT SKETCH

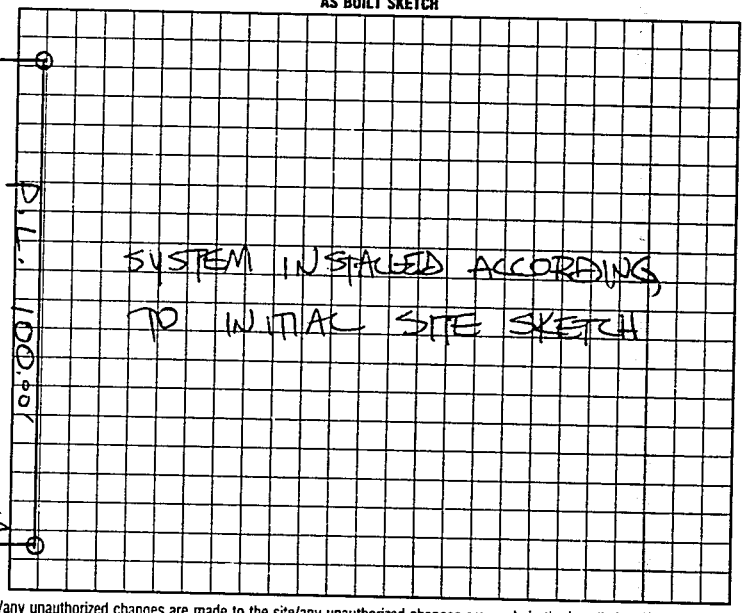

I understand that this permit can be suspended or revoked if any false information is supplied toward securing the permit/any unauthorized changes are made to the site/any unauthorized changes are made in the installation of the system.

Signed:

AUTH. TO CONST. IS VALID FOR A PERIOD EQUAL TO THE VALIDITY OF THE I.P. NOT TO EXCEED FIVE YEARS. I.P. W/SITE PLAN IS VALID FIVE YEARS.

Improvement Permit by: STEVE HEDRICK date 9-7-96

Installed by: A-1 BACKHOE

AUTHORIZATION TO CONSTRUCT

~~Existing System Inspection by~~ STEVE HEDRICK date 9-7-96

~~Certificate of Completion by:~~ date

Operation Permit by: STEVE HEDRICK date 1-31-97

HEALTH DEPT. COPY: WHITE INSPECTION COPY (FINAL): GREEN OWNER COPY (FINAL): YELLOW INSPECTION COPY (INITIAL): PINK OWNER COPY (INITIAL): GOLD