IREDELL COUNTY HEALTH DEPARTMENT - *ENVIRONMENTAL HEALTH* ☐ STATESVILLE OFFICE 704-878-5305 ☐ MOORESVILLE OFFICE 704-664-5281

IMPROVEMENT PERMIT / AUTHORIZATION TO CONSTRUCT / OPERATION PERMIT / EXISTING SYSTEM INSPECTION

PERMIT # 158642 PIN # 4726-62-6619 DATE July 19, 2011

OWNER EDWARD C. BUTALEWICZ APPLICANT: PHONE: Home/Cell # 704-682-0898 Business #

SITE ADDRESS 116 HYDE LANE STVL 28625 OWNER / APPLICANT ADDRESS SAME

SITE DIRECTIONS NC 115 NORTH, TL SCOTTS CREEK RD, TL HYDE LANE 3RD HOUSE ON RIGHT

SUBDIVISION HAMPTON GLEN BLOCK / SECTION 2 LOT # 32 LOT AREA 100' x 160' DESIGN FLOW 360 L.T.A.R. 0.30 GPD/FT

Septic Tank 1000 Gallons: STB Date

Pump Tank Gallons: P T Date

Pump Make Model Serial #

No. Nitrification Fields: 1 No. Lines 5 Linear Feet 300'

Trench Width 36" Max. Trench Bottom Depth 36" Gravel Depth N/A

☐ New System ☐ Repair ☐ Expansion System Type I II III IV V VI

System Description: 25% REDUCTION GRAVITY

Repair System Description: 50% REDUCTION Low-Pressure

Maintenance Agreement Required ☐ YES ☐ NO

☑ GRAVITY ☐ PRESSURE

☑ Residence No. Bedrooms 3

☐ Business No. Persons

☐ Other No. Employees

☐ Slab ☑ Crawl Space

☐ Basement w/plumbing ☐ Basement w/o plumbing


Water Supply: ☐ Private ☑ Public ☐ Community

Comments / Conditions

(1) KEEP OUT BUILDING MINIMUM 5' FROM SEPTIC SYSTEM & REPAIR AREA, (2) NO VEHICULAR TRAFFIC ALLOWED OVER DRAINFIELD.

INITIAL SITE SKETCH

AS BUILT SKETCH

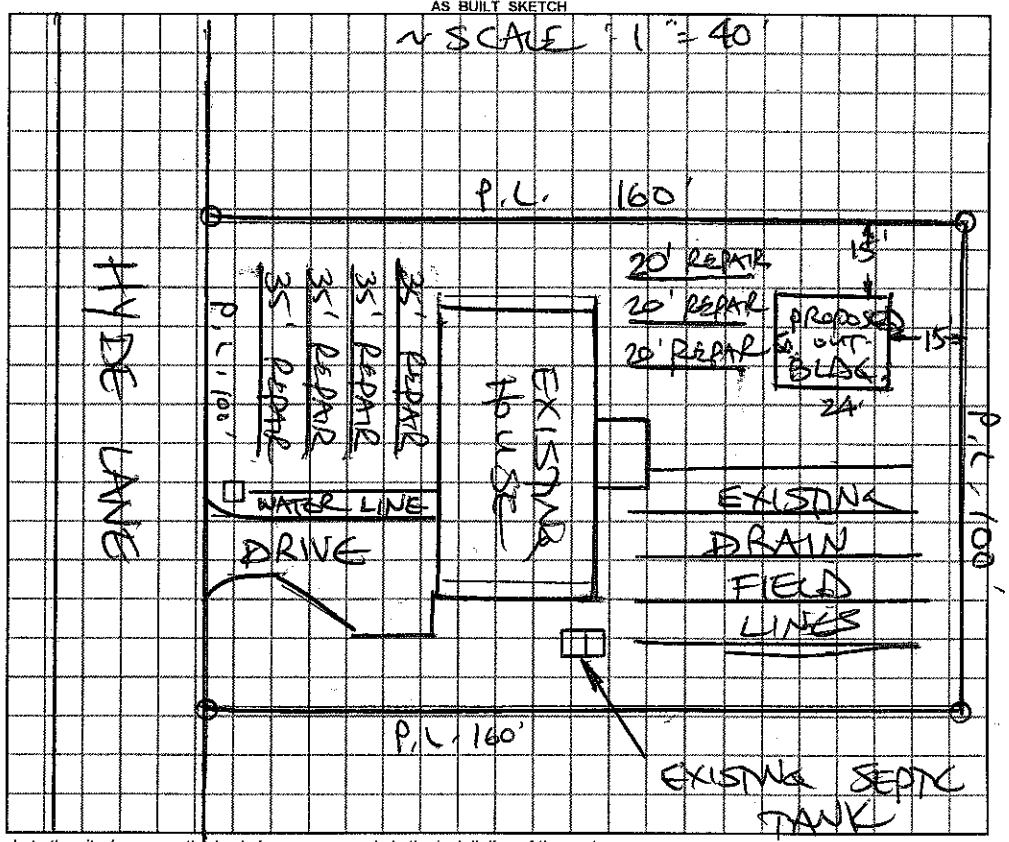

Permit can be suspended or revoked if any false information is supplied toward securing the permit / any unauthorized changes are made to the site / any unauthorized changes are made in the installation of the system.

☐ ***IMPROVEMENT PERMIT*** *with plat valid without expiration.* ☐ ***IMPROVEMENT PERMIT*** *with ~~plat valid without expiration.~~ site plan valid 60 mo.* ☐ ***AUTHORIZATION TO CONSTRUCT*** valid for period equal to IMPROVEMENT PERMIT--not to exceed 60 mo.

Owner / Applicant Signature: Edward Butalewicz Date 7-19-2011 Installed by:

IMPROVEMENT PERMIT by: ***REHS*** Date

AUTHORIZATION TO CONSTRUCT by: ***REHS*** Date

OPERATION PERMIT by: ***REHS*** Date

Existing System Inspected by: STEVE HEDRICK ***REHS*** Date July 19, 2011

YOU SHOULD CONTACT A LOCATOR SERVICE PRIOR TO ANY EXCAVATION

White Copy – Environmental Health YELLOW COPY (Final) Owner / Applicant PINK COPY (Initial) Owner / Applicant