IREDELL COUNTY HEALTH DEPARTMENT

5-18-96

STATESVILLE 704-878-5305 MOORESVILLE 704-664-5281

IMPROVEMENT PERMIT / CERTIFICATE OF COMPLETION / OPERATION PERMIT / EXISTING SYSTEM INSPECTION

PROPERTY DESCRIPTION NO. 23661 DATE ~~9A-A-34~~ TAX MAP NO. 9A-A-34 (PART) Watershed: ☐ Yes ☒ No

OWNER OR CONTRACTOR CRANDALL & O'BRIEN CONST. PHONE: Business 871-1536 Home

ADDRESS 310 TREEBARK ROAD STATESVILLE NC 28677

LOCATION NC 115 N TO SCOTTS CREEK, LOT ON LEFT PAST HYDE LANE

SUBDIVISION HAMPTON GLEN BLOCK / SECTION I LOT 34 LOT AREA 19,256 FT² SITE CLASS P5 DESIGN FLOW 360 L.T.A.R. 0.33 GAD/FT²

Septic Tank: 1000 Gallons; STB 794 Date 6-5-96

Pump Tank: _____ Gallons; PT _____ Date _____

Pump Make: _____ Model _____ Serial No. _____

Nitrification Field: No Fields 1 Square Feet 1080 Linear Feet 360

No Lines 5 Trench Width 36" Max Trench Bottom Depth 18-36" Gravel Depth 12"

☒ New System ☐ Repair System Type: (I), II, IV, V

System Description: CONVENTIONAL GRAVITY

Repair System Description: CHAMBERED GRAVITY

Maintenance Agreement Required: ☐ Yes ☒ No

☒ House/Mod. Home ☐ Mobile Home ☐ Business ☐ Other

No. Bedrooms 3 No. Bathrooms 2 No. Employees _____


☐ Slab ☒ Crawl Space ☐ Basement w/plumbing ☐ Basement wo/plumbing

Water Supply: ☐ Individual ☐ Community ☒ Public

Comments: STUB-OUT PLUMBING ABOVE FOOTINGS TO KEEP SYSTEM AS SHALLOW AS POSSIBLE

Comments:

INITIAL SITE SKETCH

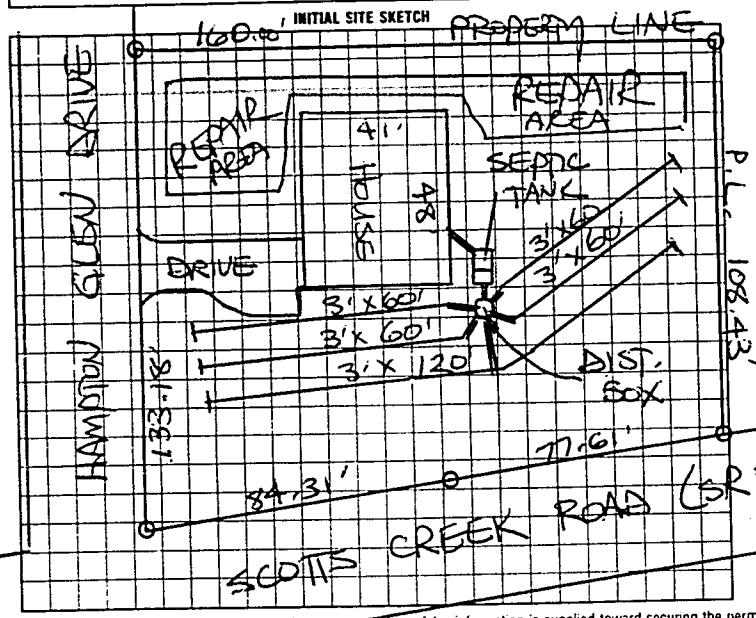

AS BUILT SKETCH

SYSTEM INSTALLED ACCORDING TO INITIAL SITE SKETCH

I understand that this permit can be suspended or revoked if any false information is supplied toward securing the permit/any unauthorized changes are made to the site/any unauthorized changes are made in the installation of the system.

Authorization to construct is valid five (5) years from date of issuance. Improvement Permit has no expiration date.

Signed _____

Improvement Permit by STEVE HEDRICK date 5-18-96

AUTHORIZATION TO CONSTRUCT: STEVE HEDRICK date 5-18-96

Installed by: A-1 BACKHOE date _____

Certificate of Completion by: _____ date _____

Operation Permit by: STEVE HEDRICK date 8-1-96

HEALTH DEPT. COPY: WHITE | INSPECTION COPY (FINAL): GREEN | OWNER COPY (FINAL): YELLOW | INSPECTION COPY (INITIAL): PINK | OWNER COPY (INITIAL): GOLD

650600