46682

IREDELL COUNTY HEALTH DEPARTMENT

STATESVILLE 704-878-5305 MOORESVILLE 704-664-5281

IMPROVEMENT PERMIT / CERTIFICATE OF COMPLETION / OPERATION PERMIT / EXISTING SYSTEM INSPECTION

PROPERTY DESCRIPTION NO. 16005 DATE 6/18/93 TAX MAP NO. 9A-9-A-9

OWNER OR CONTRACTOR SAMUEL G. SCOTT PHONE: Business Home

ADDRESS

LOCATION NC 115 N, TL SCOTTS CREEK RD, TL MILLER FARM RD, TR DOE TRAIL, 9TH LOT on (R)

SUBDIVISION DEERCROFT BLOCK / SECTION LOT 9 LOT AREA 110' X 200' SITE CLASS. PS L.T.A.R. 0.33 GPD/FT²

Water Supply: ☐ Individual ☐ Community ☑ Public

Septic Tank: 1000 Gallons; STB 358 Date 4-27-93

Pump Tank: Gallons; PT Date

Nitrification Field: No Fields 1 Square Feet 1080 Linear Feet 360

No Lines 4 Trench Width 36" Trench Depth 36" Gravel Depth 12"

☑ New System ☐ Repair System Type: I. II (III) IV. V. VI

System Description: CONV. GRAVITY

Repair System Description: CONV; GRAVITY

Maintenance Agreement Required: ☐ Yes ☑ No

☐ House/Mod. Home No. Bedrooms 3

☐ Mobile Home No. Bathrooms 2

☐ Business No. Employees

☐ Other

Garbage Disposal: ☐ Yes ☑ No

Auto. Dishwasher: ☑ Yes ☐ No

Auto. Washing Machine: ☑ Yes ☐ No


Other

☐ Slab ☑ Crawl Space ☐ Basement w/plumbing ☐ Basement wo/plumbing

Comments

INITIAL SITE SKETCH

AS BUILT SKETCH

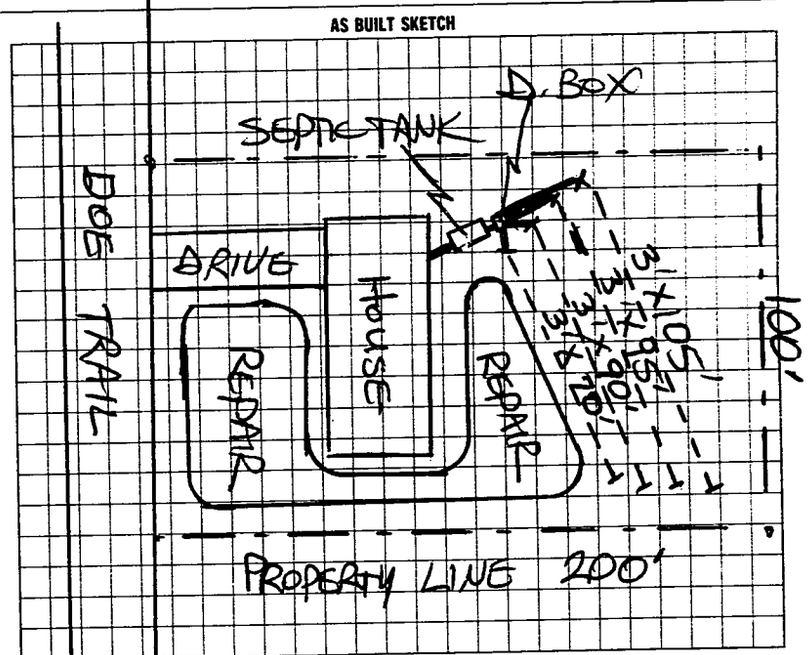

I understand that this permit can be suspended or revoked if any false information is supplied toward securing the permit/any unauthorized changes are made to the site/any unauthorized changes are made in the installation of the system Improvement Permit is valid for 60 months from date of issuance.

Signed:

Improvement Permit by: STEVE HEDRICK date 3/29/93

Existing System Inspection by: date

Installed by: DAVID YOUNTS 6/18/93

Certificate of Completion by: STEVE HEDRICK date 3/29/93

Operation Permit by: date

HEALTH DEPT. COPY: WHITE INSPECTION COPY (FINAL): GREEN OWNER COPY (FINAL): YELLOW INSPECTION COPY (INITIAL): PINK OWNER COPY (INITIAL): GOLD