IREDELL COUNTY HEALTH DEPARTMENT

STATESVILLE 704-878-5305 MOORESVILLE 704-664-5281

6/299

IMPROVEMENT PERMIT / CERTIFICATE OF COMPLETION / OPERATION PERMIT / EXISTING SYSTEM INSPECTION

PROPERTY DESCRIPTION NO. 23602 DATE 5-18-96 TAX MAP NO. 9A-A-34 (PART) Watershed: ☐ Yes ☒ No

OWNER OR CONTRACTOR CRANDALL & O'BRIAN CONST. PHONE: Business 871-1536 Home

ADDRESS 310 TREEBARK ROAD STATESVILLE, NC 28677

LOCATION NC 115N TL SCOTTS CREEK RD, LOT ON LEFT AT HYDE LANE

SUBDIVISION HAMPTON GLEN BLOCK / SECTION I LOT 19 LOT AREA 16,538 Ft² SITE CLASS PS DESIGN FLOW 360 L.T.A.R. 0.30 GPD/Ft²

Septic Tank: 1000 Gallons; STB 794 Date 4-24-96
Pump Tank: ____ Gallons; PT ____ Date ____
Pump Make: ____ Model ____ Serial No. ____
Nitrification Field: No Fields 1 Square Feet 1200 Linear Feet 400
No Lines 3 Trench Width 36" Max Trench Bottom Depth 18-36" Gravel Depth ____

☒ New System ☐ Repair System Type: I, II, III, IV, V, VI
System Description: CONV. GRAVITY
Repair System Description: CHAMBERED GRAVITY
Maintenance Agreement Required: ☐ Yes ☒ No

☒ House/Mod. Home No. Bedrooms 3
☐ Mobile Home No. Bathrooms 2
☐ Business No. Employees ____
☐ Other ____


☐ Slab ☒ Crawl Space ☐ Basement w/plumbing ☐ Basement wo/plumbing

Water Supply:
☐ Individual
☐ Community
☒ Public


Comments: SUB-OUT PLUMBING ABOVE FOOTINGS TO KEEP SYSTEM AS SHALLOW AS POSSIBLE

Comments: SYSTEM DESIGN CHANGED DUE TO RELOCATION OF DRIVEWAY

INITIAL SITE SKETCH

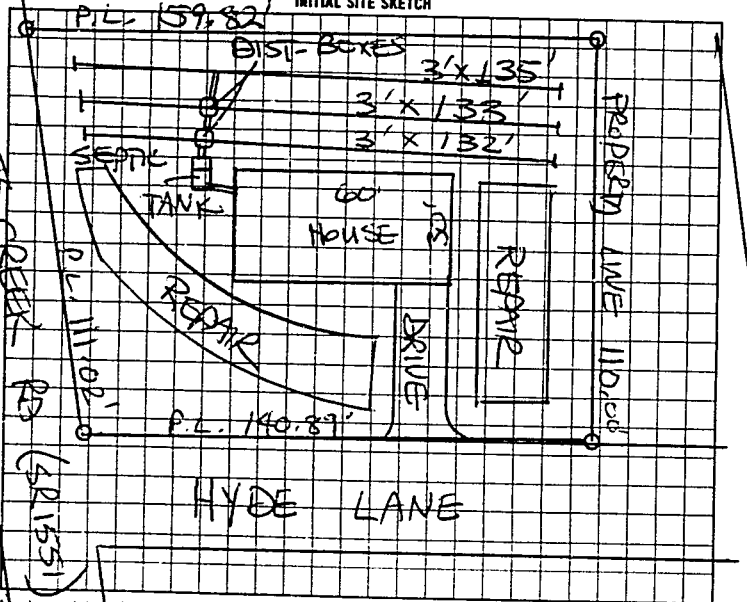

AS BUILT SKETCH

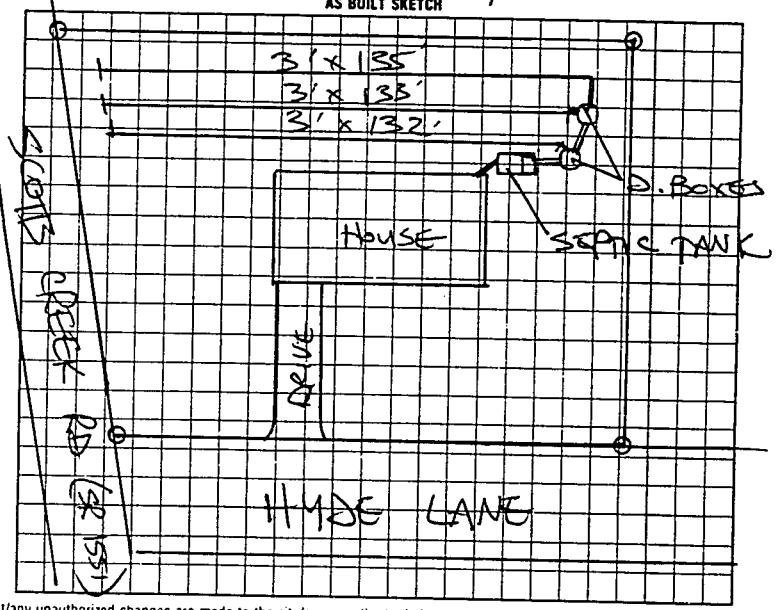

I understand that this permit can be suspended or revoked if any false information is supplied toward securing the permit/any unauthorized changes are made to the site/any unauthorized changes are made in the installation of the system.

Authorization to Construct is valid five (5) years from date of issuance. Improvement Permit has no expiration date.

Signed ____

Improvement Permit by: STEVE HEARICK date 5-18-96

Evaluation by: STEVE HEARICK date 5-18-96

AUTHORIZATION TO CONSTRUCT:

Installed by A-1 BACKHOE

Certificate of Completion by: ____ date ____

Operation Permit by STEVE HEARICK date 8-30-96

HEALTH DEPT COPY WHITE | INSPECTION COPY (FINAL) GREEN | OWNER COPY (FINAL) YELLOW | INSPECTION COPY (INITIAL) PINK | OWNER COPY (INITIAL) GOLD