63490

IREDELL COUNTY HEALTH DEPARTMENT

STATESVILLE 704-878-5305 MOORESVILLE 704-664-5281

IMPROVEMENT PERMIT / CERTIFICATE OF COMPLETION / OPERATION PERMIT / EXISTING SYSTEM INSPECTION

PROPERTY DESCRIPTION NO. 25106 DATE 10-8-96 ~~TAX MAP~~ PIN NO. 4726629377 Watershed: ☐ Yes ☑ No

OWNER OR CONTRACTOR CRANDALL & O'BRIEN PHONE: Business 871-1536 Home

ADDRESS 310 TREEBARK ROAD, STATESVILLE NC 28677

LOCATION NC 115 N, TL SCOTTS CREEK, TL HAMPTON GLEN DRIVE, 6th LOT ON RIGHT

SUBDIVISION HAMPTON GLEN BLOCK / SECTION II LOT 12 LOT AREA 15,122.33 FT² SITE CLASS PS DESIGN FLOW 360 L.T.A.R. 0.30 GPD/FT²

Septic Tank: 1000 Gallons; STB 1012 Date 9-11-96
Pump Tank: ____ Gallons; PT ____ Date ____
Pump Make: ____ Model ____ Serial No. ____
Nitrification Field: No Fields 1 Square Feet EQ TO 1200 Linear Feet 300'
No Lines FOUR Trench Width 36" Max Trench Bottom Depth 36" Gravel Depth N/A

☑ New System ☐ Repair System Type: I, II, III, IV, V, VI
System Description: CHAMBERED GRAVITY
Repair System Description: PUMP
Maintenance Agreement Required: ☐ Yes ☑ No
☐ Slab ☑ Crawl Space ☐ Basement w/plumbing ☐ Basement wo/plumbing


☑ House/Mod. Home No. Bedrooms 3
☐ Mobile Home No. Bathrooms 2
☐ Business No. Employees ____
☐ Other ____

Water Supply: ☐ Individual ☐ Community ☑ Public


Comments: INSTALL 52 CHAMBERS IN FOUR EQUAL LENGTH LINES AS SHOWN.

Comments:

INITIAL SITE SKETCH

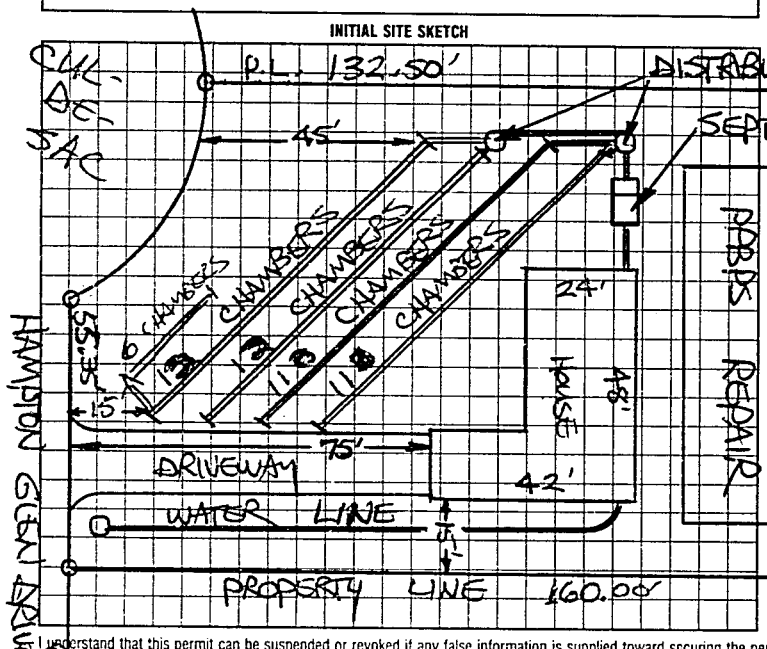

AS BUILT SKETCH

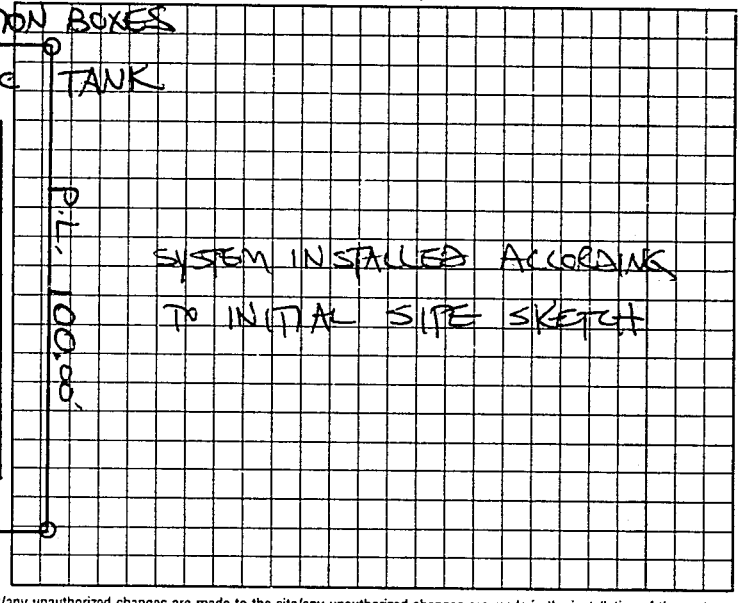

I understand that this permit can be suspended or revoked if any false information is supplied toward securing the permit/any unauthorized changes are made to the site/any unauthorized changes are made in the installation of the system.

Sign here: AUTH. TO CONST. IS VALID FOR A PERIOD EQUAL TO THE VALIDITY OF THE I.P. NOT TO EXCEED FIVE YEARS. I.P. W/SITE PLAN IS VALID FIVE YEARS.

Improvement Permit by: STEVE HEDRICK date 10-8-96
AUTHORIZATION TO CONSTRUCT
Construction Inspection by: STEVE HEDRICK date 10-8-96
HEALTH DEPT COPY WHITE INSPECTION COPY (FINAL) GREEN OWNER COPY (FINAL) YELLOW INSPECTION COPY (INITIAL) PINK

Installed by: A-1 BACKHOE
~~Certificate of Completion by:~~ ____ date ____
Operation Permit by: STEVE HEDRICK date 12-20-96