63255

IREDELL COUNTY HEALTH DEPARTMENT

STATESVILLE 704-878-5305 MOORESVILLE 704-664-5281

IMPROVEMENT PERMIT / CERTIFICATE OF COMPLETION / OPERATION PERMIT / EXISTING SYSTEM INSPECTION

PROPERTY DESCRIPTION NO. 25110 DATE 9-23-96 ~~TAX MAP~~ PIN NO. 4726629786 Watershed: ☐ Yes ☑ No

OWNER OR CONTRACTOR CRANDALL & O'BRIEN PHONE: Business 871-1536 Home

ADDRESS 310 TREE BARK ROAD STATESVILLE NC 28677

LOCATION NC 115 N TL SCOTTS CREEK ROAD, TL HAMPTON GLEN DRIVE, 2ND LOT ON RIGHT

SUBDIVISION HAMPTON GLEN BLOCK / SECTION II LOT 16 LOT AREA 100 x 160 SITE CLASS PS DESIGN FLOW 360 L.T.A.R. 0.30 GPD/FT²

Septic Tank: 1000 Gallons; STB 10/2 Date 9/21/96
Pump Tank: ____ Gallons; PT ____ Date ____
Pump Make: ____ Model ____ Serial No. ____
Nitrification Field: No Fields 1 Square Feet EQ TO 1200 Linear Feet 300+
No Lines FIVE Trench Width 36" Max Trench Bottom Depth 36" Gravel Depth N/A

☑ New System ☐ Repair System Type: I, II, III, IV, V, VI
System Description: CHAMBERED GRAVITY
Repair System Description: CHAMBERED PUMP
Maintenance Agreement Required: ☐ Yes ☑ No

☑ House/Mod. Home No. Bedrooms 3
☐ Mobile Home No. Bathrooms 2
☐ Business No. Employees ____
☐ Other ____


☐ Slab ☑ Crawl Space ☐ Basement w/plumbing ☐ Basement wo/plumbing

Water Supply:
☑ Individual
☐ Community
☑ Public

Comments: INSTALL FIFTY CHAMBERS IN FIVE LINES AS SHOWN BELOW

Comments:

INITIAL SITE SKETCH

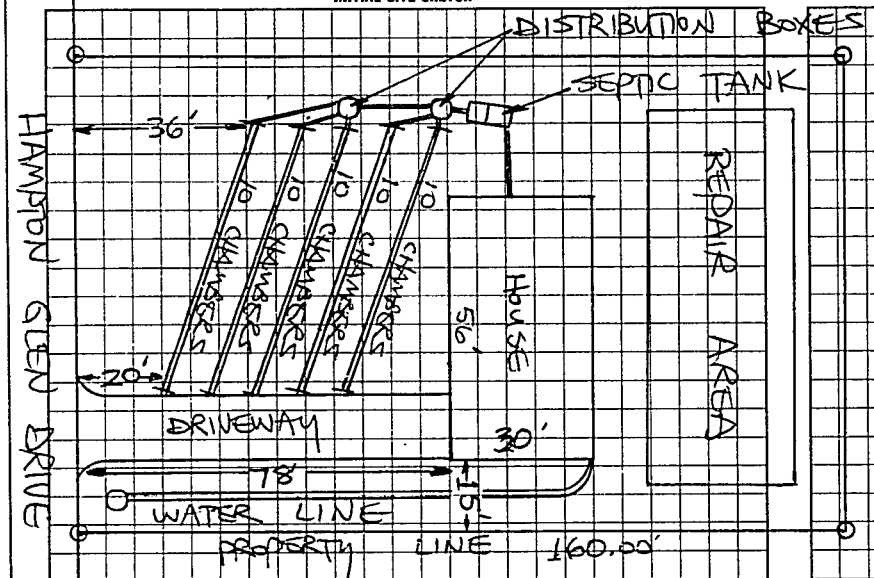

AS BUILT SKETCH

SYSTEM INSTALLED ACCORDING TO INITIAL SITE SKETCH

I understand that this permit can be suspended or revoked if any false information is supplied toward securing the permit/any unauthorized changes are made to the site/any unauthorized changes are made in the installation of the system.
AUTH. TO CONST. IS VALID FOR A PERIOD EQUAL TO THE VALIDITY OF THE I.P. NOT TO EXCEED FIVE YEARS. I.P. W/ SITE PLAN IS VALID FIVE YEARS

Signed: [signature]

Installed by: A-1 BACKHOE

Improvement Permit by: STEVE HENDRICK date 9-23-96

~~Certificate of Completion by:~~ ____ date ____

AUTHORIZATION TO CONSTRUCT Existing System Inspection by: STEVE HENDRICK date 9-23-96

Operation Permit by: STEVE HENDRICK date 12-20-96

HEALTH DEPT. COPY: WHITE INSPECTION COPY (FINAL): GREEN OWNER COPY (FINAL): YELLOW INSPECTION COPY (INITIAL): PINK OWNER COPY (INITIAL): GOLD

9 L 0 Σ 0 0