11:30

IREDELL COUNTY HEALTH DEPARTMENT

STATESVILLE 704-878-5305 MOORESVILLE 704-664-5281

IMPROVEMENT PERMIT / CERTIFICATE OF COMPLETION / OPERATION PERMIT / EXISTING SYSTEM INSPECTION

PROPERTY DESCRIPTION NO. 21960 DATE 8-29-95 TAX MAP NO. 9A-A-4A

OWNER OR CONTRACTOR GLENDA BOWLES PHONE: Business Home 873-5097 Watershed: ☐ Yes ☒ No

ADDRESS 364 SCOTTS CREEK ROAD, STATESVILLE, NC 28677

LOCATION NC115N, TL SCOTTS CREEK RD, 5th HOUSE ON RIGHT PAST CABINET SHOP.

SUBDIVISION BLOCK / SECTION LOT LOT AREA 0.79 AC SITE CLASS PS DESIGN FLOW 240 L.T.A.R. 0.33 GPD/FT²

Septic Tank: 1000 Gallons; STB 794 Date 1-16-95
Pump Tank: Gallons; PT Date
Pump Make: Model Serial No.
Nitrification Field: No Fields 1 Square Feet 720 Linear Feet 240
No Lines 3 Trench Width 36" Max Trench Bottom Depth 18-36" Gravel Depth 12"

☑ New System ☐ Repair System Type: I II III, IV, V, VI
System Description: CONVENTIONAL GRAVITY
Repair System Description: MAX. FEASIBLE
Maintenance Agreement Required: ☐ Yes ☑ No

☐ House/Mod. Home ☑ Mobile Home ☐ Business ☐ Other
No. Bedrooms 3/2 No. Bathrooms No. Employees


☐ Slab ☑ Crawl Space ☐ Basement w/plumbing ☐ Basement wo/plumbing

Water Supply: ☐ Individual ☐ Community ☑ Public

Comments: ① KEEP SYSTEM MINIMUM 5' FROM PROPERTY LINES ② INSTALL SYSTEM AS SHOWN, ON CONTOUR NO DEEPER THAN 36", 9' APART ON CENTER

Comments:

INITIAL SITE SKETCH

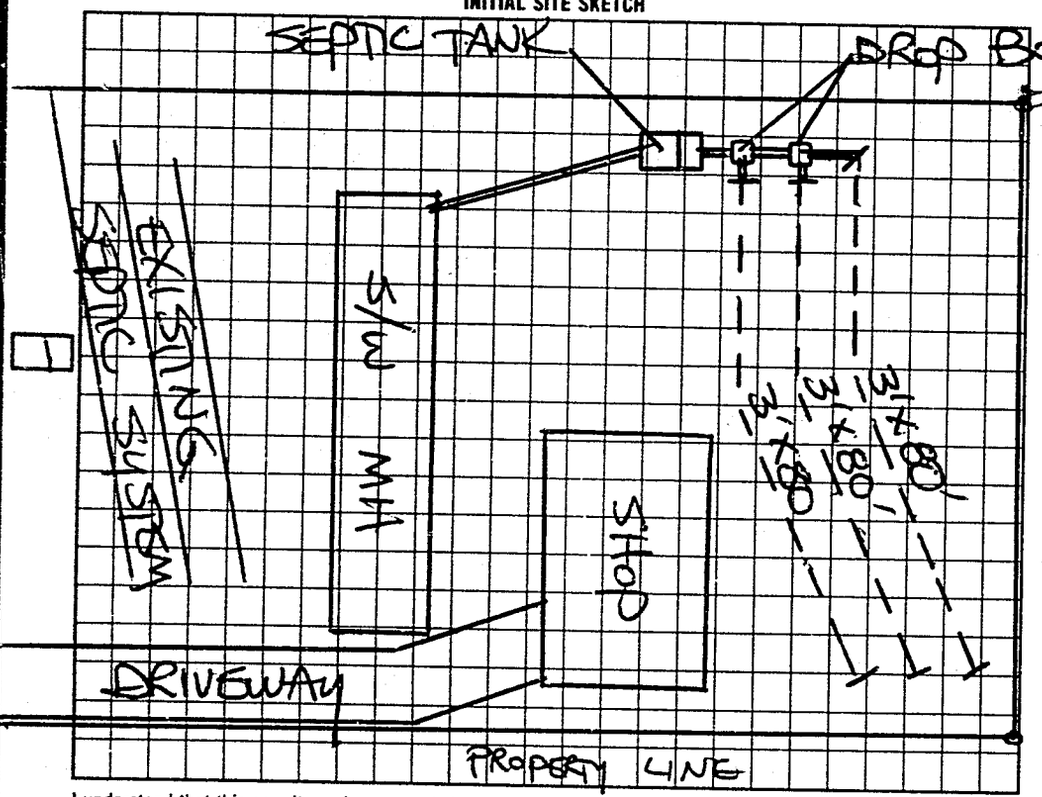

AS BUILT SKETCH

Same as initial Sketch

I understand that this permit can be suspended or revoked if any false information is supplied toward securing the permit/any unauthorized changes are made to the site/any unauthorized changes are made in the installation of the system.

Signed: T Glenda Bowles

Improvement Permit by: STEVE HEDRICK date 8-29-95

Existing System Inspection by: date

Installed by: James Hutley

Certificate of Completion by: P. C. Moore date 9-22-95

Operation Permit by: date

HEALTH DEPT COPY: WHITE INSPECTION COPY (FINAL): GREEN OWNER COPY (FINAL): YELLOW INSPECTION COPY (INITIAL): PINK OWNER COPY (INITIAL): GOLD