IREDELL COUNTY HEALTH DEPARTMENT

IMPROVEMENT PERMIT / AUTHORIZATION TO CONSTRUCT / OPERATION PERMIT / EXISTING SYSTEM INSPECTION

STATESVILLE 704-878-5305 MOORESVILLE 704-664-5281

PERMIT# REPAIR PIN# 4726-63-6251 DATE 5-9-07

OWNER OR APPLICANT WILLIAM THOMAS MITCHELL PHONE: Business Home 336-687-5691

ADDRESS 334 SCOTTS CREEK ROAD, STATESVILLE, NC 28625

LOCATION NC 115 NORTH, TL SCOTTS CREEK ROAD, HOUSE ON RIGHT AT #334

SUBDIVISION BLOCK / SECTION LOT LOT AREA 1.65 ACRES SITE CLASS. PS DESIGN FLOW 480 L.T.A.R. 0.30 GAD/SQ FT

Septic Tank: EXISTING Gallons; STB Date

Pump Tank: Gallons; PT Date

Pump Make: Model Serial No.

Nitrification Field: No Fields 1 Square Feet EQ TO 1600 Linear Feet 400'

No Lines FOUR Trench Width 36" Max Trench Bottom Depth 36" Gravel Depth N/A

☐ New System ☒ Repair ☐ Expansion System Type: I II III IV V VI

System Description:

Repair System Description: 25% REDUCTION

Maintenance Agreement Required: ☐ Yes ☒ No

☒ Gravity ☐ Pressure ☐ Slab ☒ Crawl Space ☐ Basement w/plumbing ☐ Basement wo/plumbing


☒ House/Mod. Home ☐ Mobile Home ☐ Business ☐ Other

No. Bedrooms 4 No. Persons No. Employees

Water Supply: ☒ Individual ☐ Public ☐ Community


Comments/Conditions: ① NOV. ISSUED TO BE REPAIRED BY 6-8-07
② INSTALL THREE NEW DROP BOXES FEEDING 25% REDUCTION SYSTEM AS FLAGGED
③ START NEW LINES MINIMUM 5' FROM OLD

INITIAL SITE SKETCH

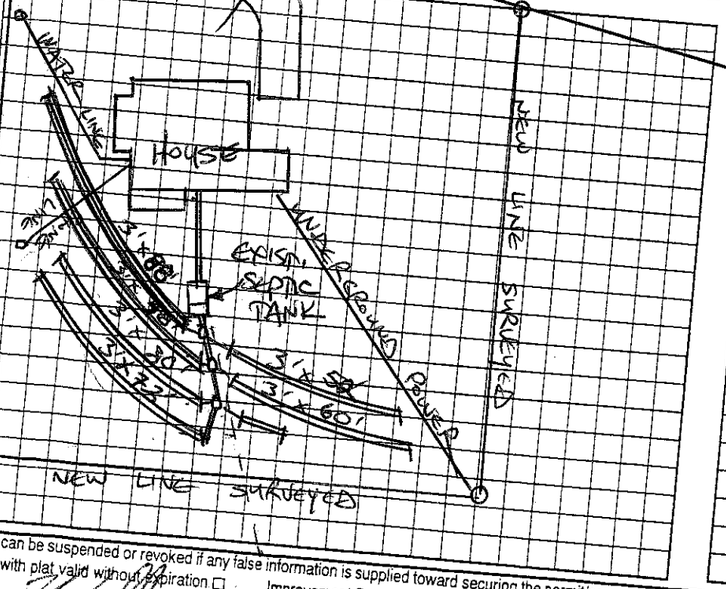

Comments/Conditions: SYSTEM REPAIRED ACCORDING TO INITIAL SITE SKETCH

AS BUILT SKETCH

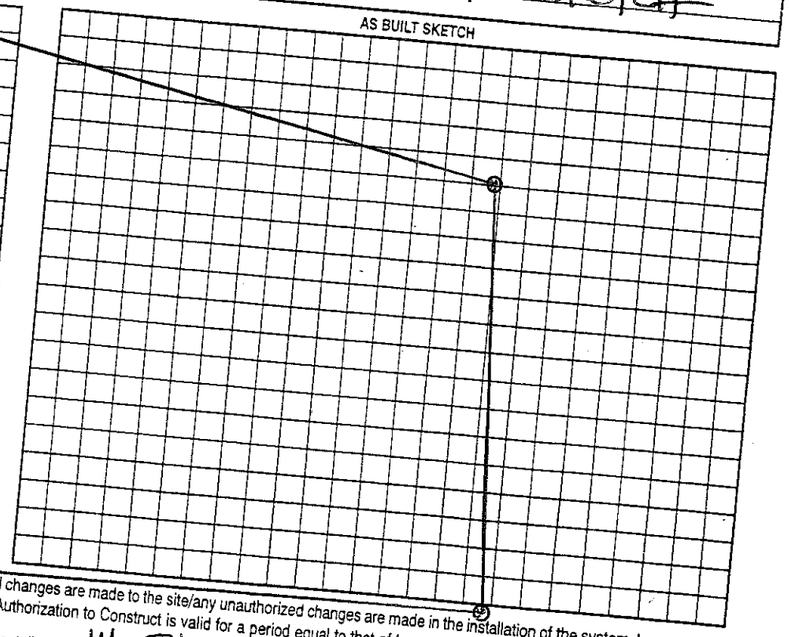

Permit can be suspended or revoked if any false information is supplied toward securing the permit/any unauthorized changes are made to the site/any unauthorized changes are made in the installation of the system. Improvement Permit with plat valid without expiration ☐ Improvement Permit with site plan valid for sixty months ☒ Authorization to Construct is valid for a period equal to that of Improvement Permit – not to exceed sixty months.

Signed: William Thomas Mitchell date 5-9-07

Improvement Permit by: STEVE HENDRICK date 5-9-07

Authorization to Construct by: STEVE HENDRICK date 5-9-07

Installed by: WM. THOMAS MITCHELL ROBBIE BROWN

Operation Permit by: STEVE HENDRICK date 7-7-08

Existing System Inspection by: date

HEALTH DEPT. COPY: WHITE OWNER COPY (FINAL): YELLOW OWNER COPY (INITIAL): PINK