IREDELL COUNTY HEALTH DEPARTMENT

STATESVILLE 704-878-5305 MOORESVILLE 704-664-5281

IMPROVEMENT PERMIT / AUTHORIZATION TO CONSTRUCT / OPERATION PERMIT / EXISTING SYSTEM INSPECTION

PERMIT# 083796 PIN# 4726 70 9215 (PT) DATE 9-24-99

OWNER OR CONTRACTOR SONOMA BUILDERS, INC PHONE: Business (704) 376-6571 Home

ADDRESS 1505 BILTMORE DR, CHARLOTTE NC 28207

LOCATION NC 115 N, TL SCOTTS CREEK, TL MILLER FARM, TR FAWNWOOD, LOT ON RIGHT BEFORE CUL-DE-SAC

SUBDIVISION FAWNWOOD BLOCK / SECTION II LOT 13 LOT AREA 0.97 ACRE SITE CLASS PS DESIGN FLOW 360 L.T.A.R. 0.35 GPD/FT²

Septic Tank: 1000 Gallons: STB 1012 Date 11-7-99
Pump Tank: Gallons: PT Date
Pump Make: Model Serial No
Nitrification Field: No Fields 1 Square Feet EQ TO 1035 Linear Feet 258+
No Lines FIVE Trench Width 36" Max Trench Bottom Depth 36" Stone Depth SAND 6"

✓ New System Repair System Type: I II III IV V
System Description 25% REDUCTION GRAVITY
Repair System Description 25% REDUCTION, PUMP
Maintenance Agreement Required Yes ✓No

House/Mod. Home No. Bedrooms 3
Mobile Home No. Bathrooms 2
Business No. Employees
Other


Slab ✓Crawl Space Basement w/plumbing Basement wo/plumbing

Water Supply: ☐ Individual ☑ Public ☐ Community

Comments/Conditions: INSTALL 43 CHAMBERS (AT REQUEST) IN FIVE LINES ON CONTOUR AS SHOWN.

Comments Conditions: SEPTIC TANK WITH RISERS INSTALLED USING "POLYLOK" FILTER

INITIAL SITE SKETCH SCALE: 1"=40'

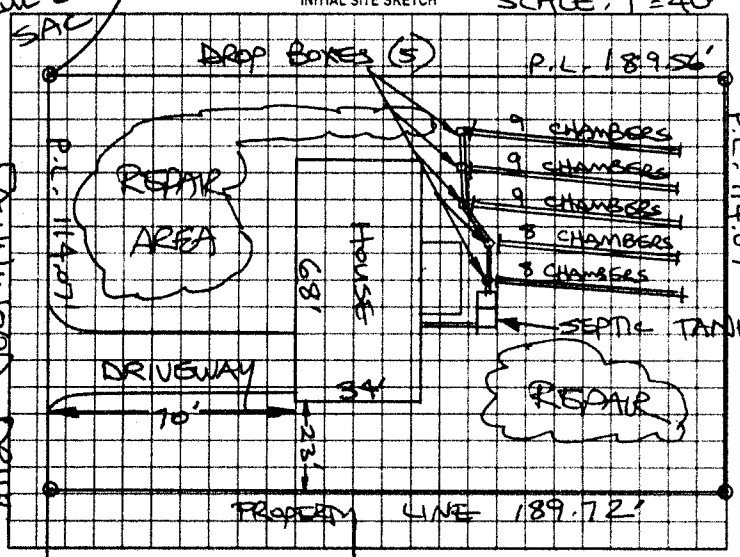

AS BUILT SKETCH

SYSTEM INSTALLED ACCORDING TO INITIAL SITE SKETCH

Permit can be suspended or revoked if any false information is supplied toward securing the permit; any unauthorized changes are made to the site; any unauthorized changes are made in the installation of the system. Improvement Permit with plat valid without expiration. Improvement Permit with site plan valid for sixty months. Authorization to Construct is valid for a period equal to that of Improvement Permit – not to exceed sixty months.

Signed: Steve D. Hedrick date 9/27/99 Installed by TOMMY FRYE

Improvement Permit by: STEVE HEDRICK date 9-24-99 Operation Permit by STEVE HEDRICK date 3-3-00

Authorization to Construct by: STEVE HEDRICK date 9-24-99 Existing System Inspection by date

HEALTH DEPT COPY WHITE OWNER COPY (FINAL) YELLOW OWNER COPY (INITIAL) PINK