IREDELL COUNTY HEALTH DEPARTMENT

STATESVILLE 704-878-5305 MOORESVILLE 704-664-5281

IMPROVEMENT PERMIT / AUTHORIZATION TO CONSTRUCT / OPERATION PERMIT / EXISTING SYSTEM INSPECTION

PERMIT # Repair PIN # 4726-70-1684 DATE 26 August 09

OWNER or APPLICANT Todd Carter PHONE: Business (704) 201-4294 Home:

OWNER or APPLICANT ADDRESS 1663 Scotland Ave. Chmnville, NC.

LOCATION / DIRECTIONS Scotts Creek Rd. from 115. 1/2 mile from Rd. - Prop. on Rt. past Fanwood Dr.

SUBDIVISION Fanwood BLOCK / SECTION I LOT # 6 LOT AREA DESIGN FLOW 360 gpd L.T.A.R. 0.3/597d

Septic Tank	Exist.	Gallons: STB		Date		☐ New System	☑ Repair	☐ Expansion System	Type I II (III) IV V VI
Pump Tank		Gallons: P T		Date		System Description:			
Pump Make		Model		Serial #		Repair System Description:	25% Reduction System		
Nitrification Field No Fields	1	No Lines	4	Linear Feet	340'	Maintenance Agreement Required	☐ YES	☑ NO	
Trench Width	36"	Max. Trench Bottom Depth	30"	Gravel Depth		☑ GRAVITY	☐ PRESSURE		

☑ Residence	No. Bedrooms	3	Water Supply		
☐ Business	No. Persons		☐ Private		
☐ Other	No. Employees		☑ Public		
☐ Slab	☑ Crawl Space		☐ Community		
☐ Basement w/plumbing	☐ Basement w/o plumbing				

Comments / Conditions
* Relocate water line /
* Relocate phone line, power, etc. as needed for proper installation.

Comments / Conditions

INITIAL SITE SKETCH

* Please see Attached Site Sketch.

AS BUILT SKETCH

Install as Drawn

Permit can be suspended or revoked if any false information is supplied toward securing the permit / any unauthorized changes are made to the site / any unauthorized changes are made in the installation of the system.

☐ *IMPROVEMENT PERMIT w / plat valid without expiration* ☐ *IMPROVEMENT PERMIT w / site plan valid for 60 mos.* ☑ *AUTHORIZATION TO CONSTRUCT valid for period equal to IMPROVEMENT PERMIT-not to exceed 60 mo.*

Owner / Applicant Signature: Date

Improvement Permit by: Date

Authorization to Construct by: Date 26 Aug 09

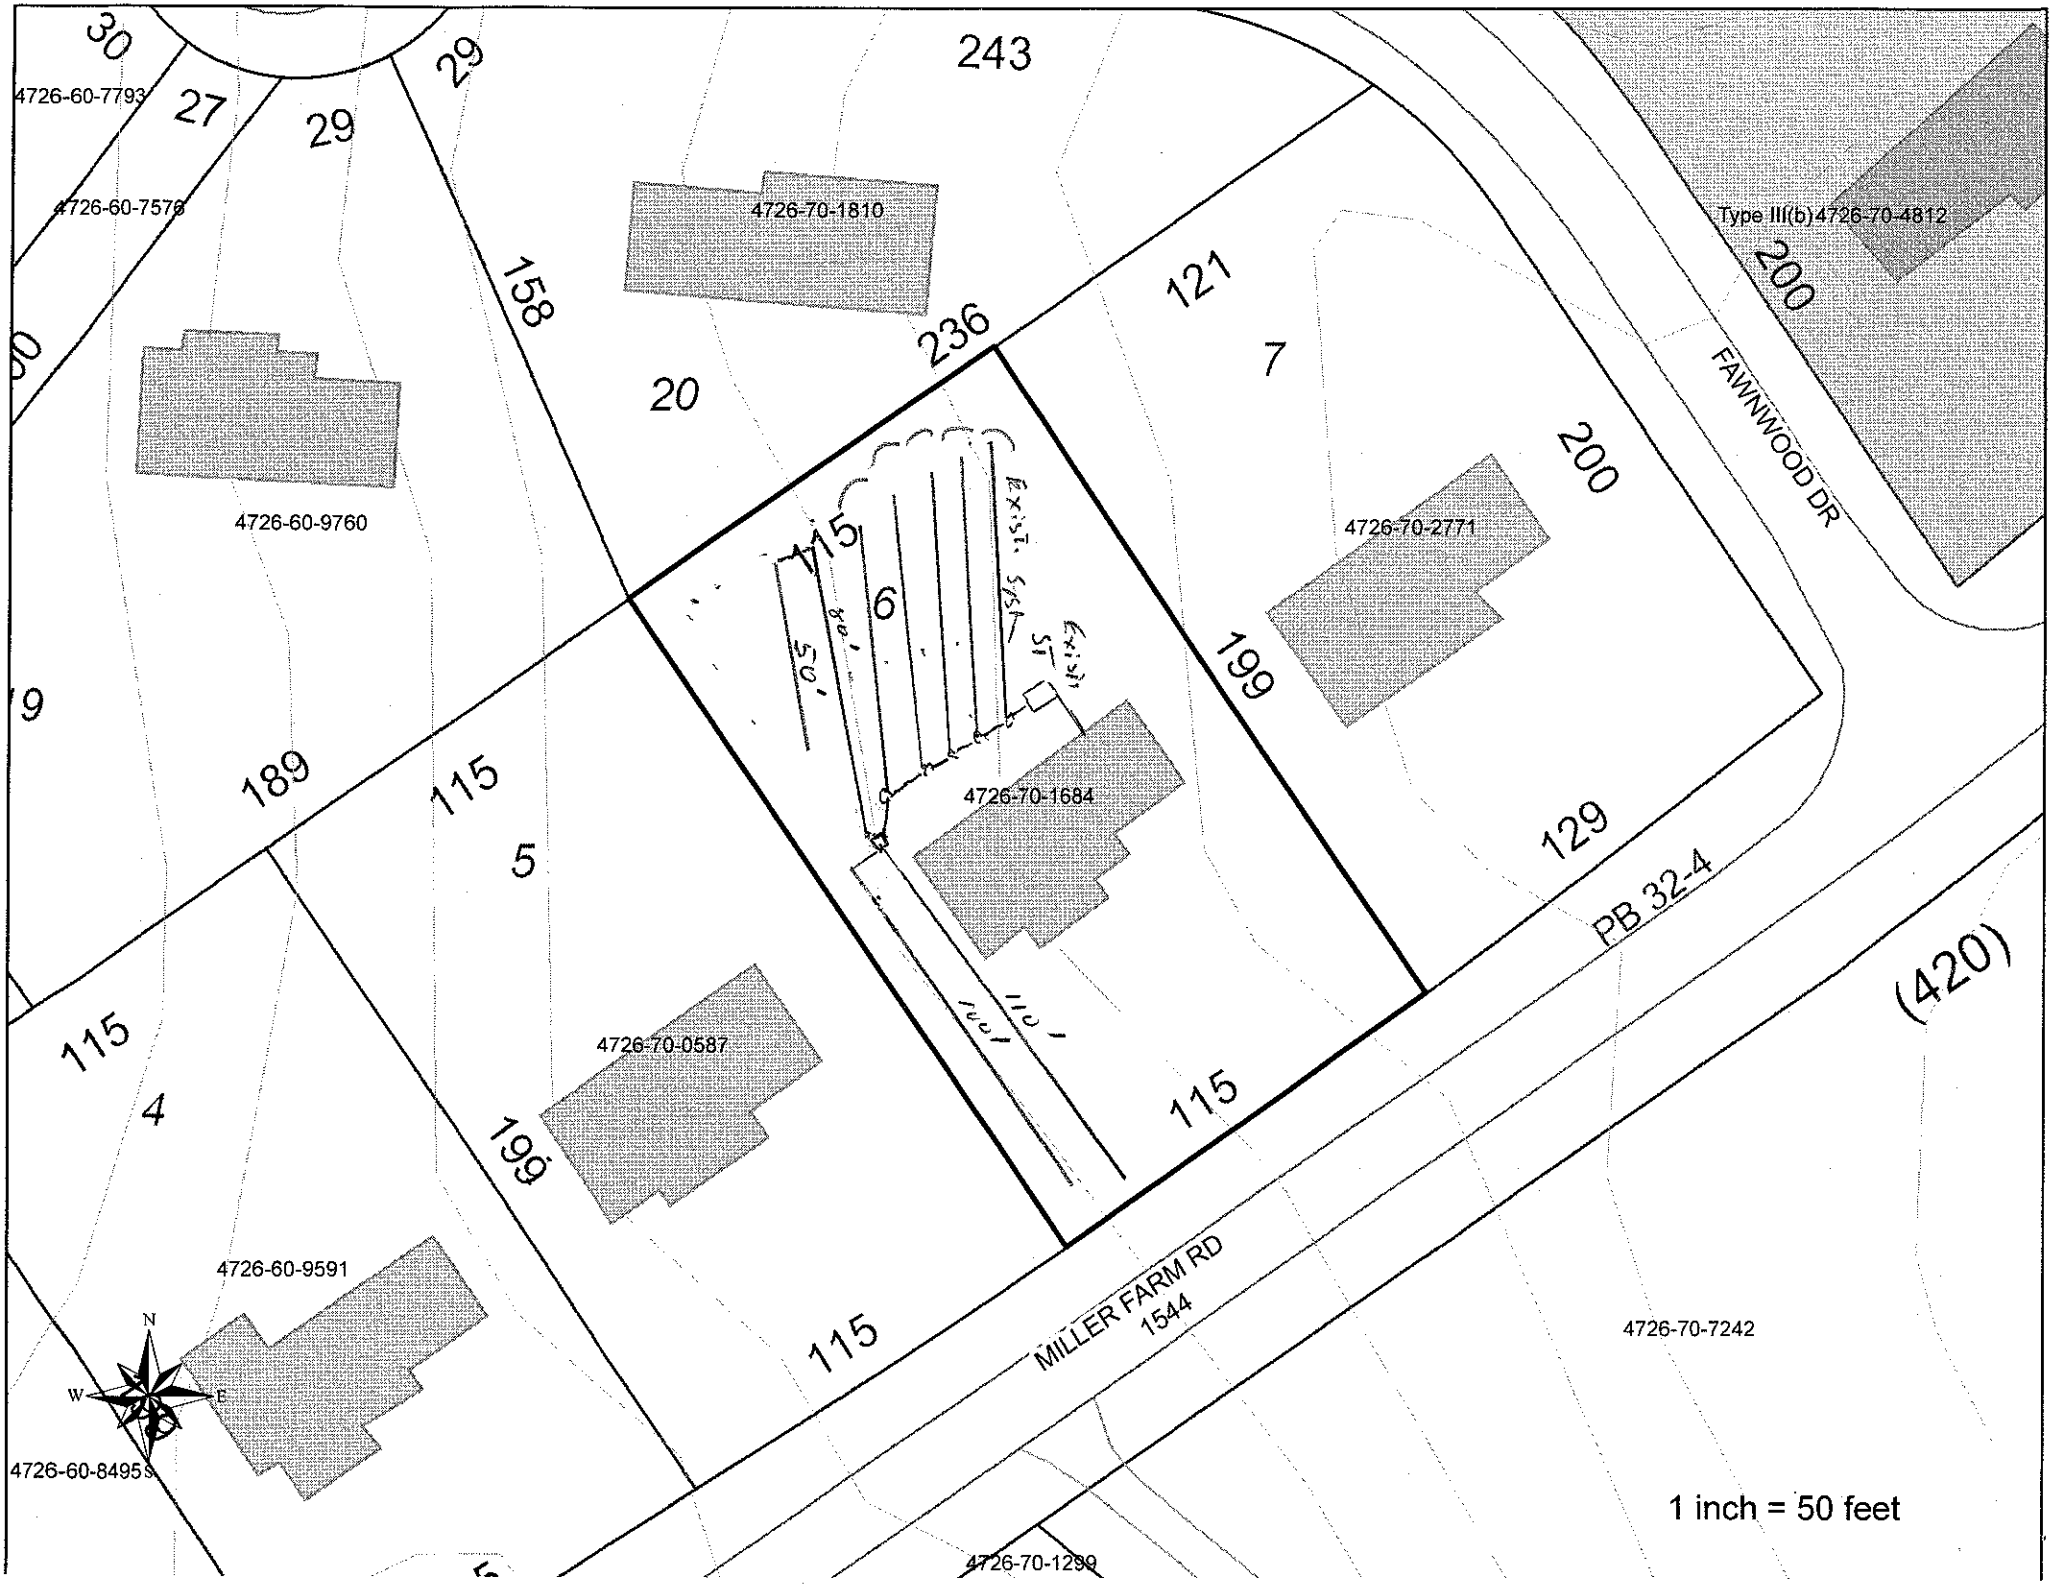
Installed by: Steve Jordan

Operation Permit by: , R.S. Date: 3 Sept. 09

Existing System Inspected by: Date:

YOU SHOULD CONTACT A LOCATOR SERVICE PRIOR TO ANY EXCAVATION.

WHITE COPY Environmental Health YELLOW COPY (Final) Owner / Applicant PINK COPY (Initial) Owner / Applicant


4726-60-7793
27
29
30
29
243
4726-60-7578
4726-70-1810
Type III(b)4726-70-4812
200
158
236
121
7
20
FAWNWOOD DR
4726-60-9760
200
4726-70-2771
115
6
199
189
115
4726-70-1684
5
129
PB 32-4
(420)
115
4
4726-70-0587
199
115
MILLER FARM RD
1544
4726-60-9591
115
4726-70-7242
N
W
E
4726-60-8495
1 inch = 50 feet
4726-70-1290