IREDELL COUNTY HEALTH DEPARTMENT

STATESVILLE 704-878-5305 MOORESVILLE 704-664-5281

IMPROVEMENT PERMIT / AUTHORIZATION TO CONSTRUCT / OPERATION PERMIT / EXISTING SYSTEM INSPECTION

PERMIT# 083795 PIN# 4726 70 9215 (PT) DATE 9-24-99

OWNER OR CONTRACTOR STANDARD BLDG. CO. PHONE: Business 585-2211 Home

ADDRESS 202 HARRIS BRIDGE ROAD, STONY POINT, NC 28678

LOCATION NC 115 N, TL SCOTTS CREEK, TL MILLER FARM, TR FAWNWOOD DRIVE, LOT ON RIGHT

SUBDIVISION FAWNWOOD BLOCK / SECTION II LOT 12 LOT AREA 0.501 ACRE SITE CLASS P3 DESIGN FLOW 360 L.T.A.R. 0.30 GAD/FPD

Septic Tank: 1000 Gallons; STB 1012 Date 7-18-99
Pump Tank: - Gallons; PT Date
Pump Make: Model Serial No.
Nitrification Field: No Fields 1 Square Feet 840 TO 1250 Linear Feet 300+
No Lines SIX Trench Width 36" Max Trench Bottom Depth 36" Gravel Depth SAND 6"

☑ New System ☐ Repair System Type: I, II, III, IV, V, VI
System Description: 25% REDUCTION GRAVITY
Repair System Description: 25% REDUCTION PUMP
Maintenance Agreement Required: ☐ Yes ☑ No

☑ House/Mod. Home ☐ Mobile Home ☐ Business ☐ Other
No. Bedrooms 3 No. Bathrooms 2 No. Employees


☐ Slab ☑ Crawl Space ☐ Basement w/plumbing ☐ Basement wo/plumbing

Water Supply: ☐ Individual ☒ Public ☐ Community

Comments/Conditions: INSTALL 50 CHAMBERS ON CONTOUR (AT REQUEST) IN SIX LINES AS SHOWN

Comments/Conditions: SEPTIC TANK WITH RISERS INSTALLED USING "POLYLOK" FILTER

INITIAL SITE SKETCH SCALE: 1"=40'

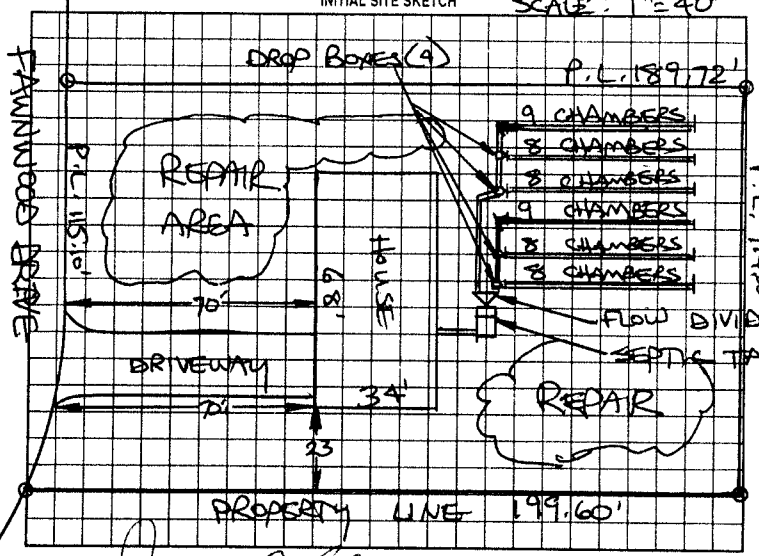

AS BUILT SKETCH

SYSTEM INSTALLED ACCORDING TO INITAL SITE SKETCH

Permit can be suspended or revoked if any false information is supplied toward securing the permit/any unauthorized changes are made to the site/any unauthorized changes are made in the installation of the system. Improvement Permit with plat valid without expiration. Improvement Permit with site plan valid for sixty months. Authorization to Construct is valid for a period equal to that of Improvement Permit – not to exceed sixty months.

Signed: _____ date _____

Improvement Permit by: STEVE HEDRICK date 9-24-99

Authorization to Construct by: STEVE HEDRICK date 9-24-99

Installed by: TOMMY PRYE

Operation Permit by: STEVE HEDRICK date 11-23-99

Existing System Inspection by: _____ date _____

HEALTH DEPT COPY WHITE OWNER COPY (FINAL) YELLOW OWNER COPY (INITIAL) PINK